


# T. 38 S., R. 8 W., W.M.

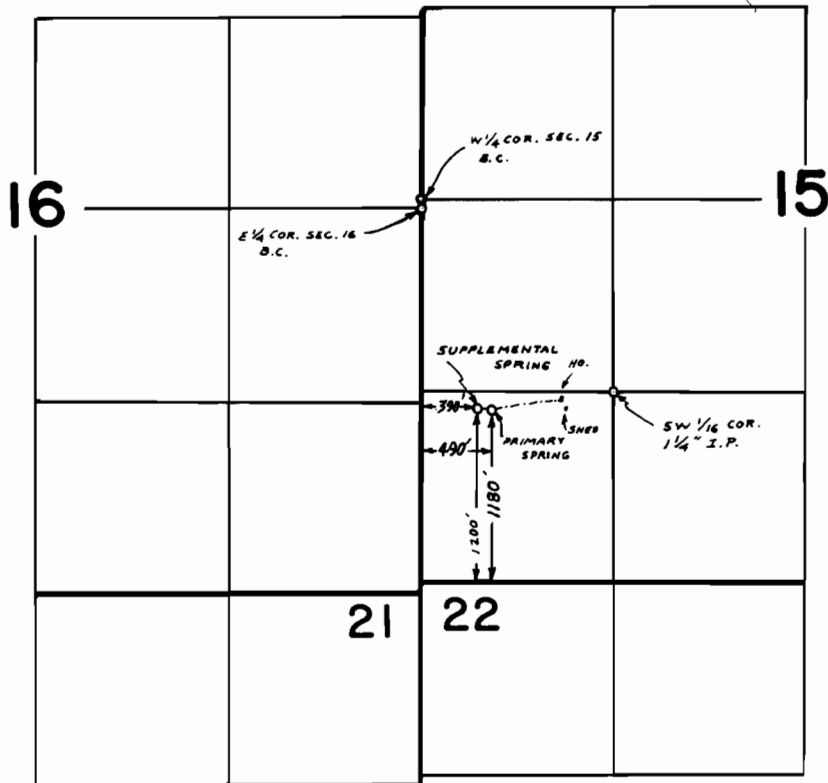

## FINAL PROOF SURVEY UNDER

Application No. 47526      Permit No. 35267      PRIMARY  
48706      35507      SUPPL.  
 IN NAME OF

ALPHA R. HARRISON

Surveyed JUL. 28 1978, by B. SUND