


T. 38 S., R. 8 W., W.M.

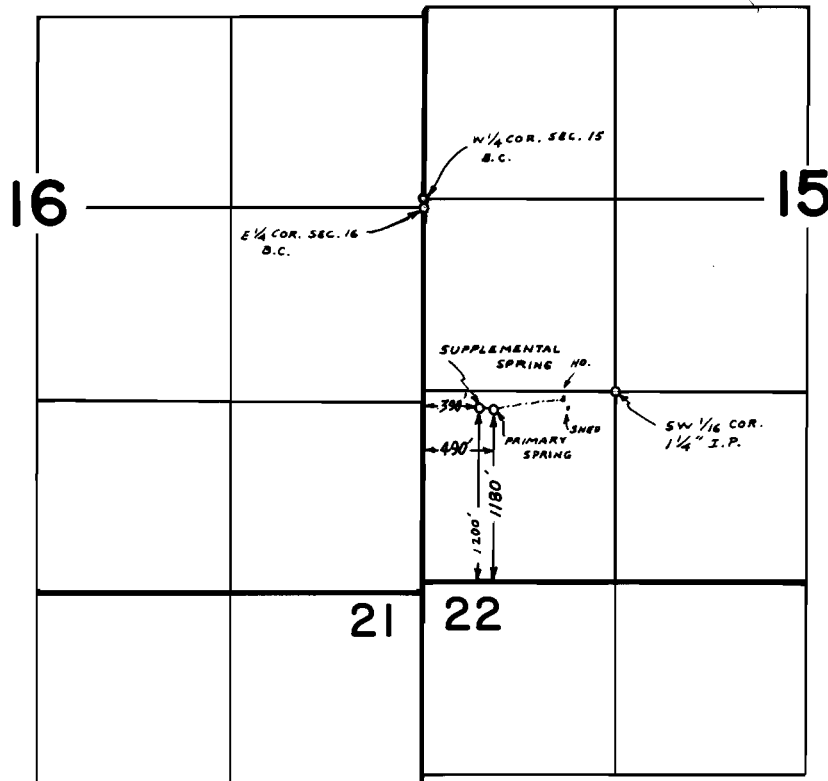

FINAL PROOF SURVEY UNDER

Application No. 47526 48706 Permit No. 35267 35507
IN NAME OF

ALPHA R. HARRISON

Surveyed JUL. 28 1978, by B. SUND

PRIMARY
SUPPL.