


T. 40S., R. 9W., W.M.

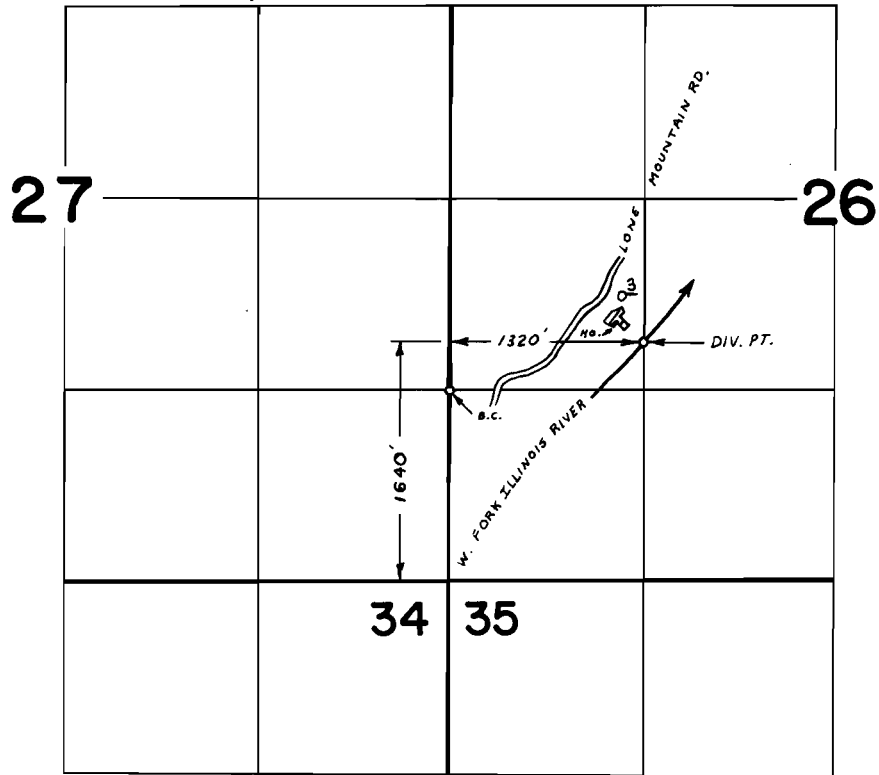

**FINAL PROOF SURVEY**  
UNDER

Application No. 47125 Permit No. 35287  
IN NAME OF

JOHN L. & JEWELL I. HARTFORD

Surveyed AUG. 8 1978, by B. SUND