


T. 38 S., R. 8 W., W.M.

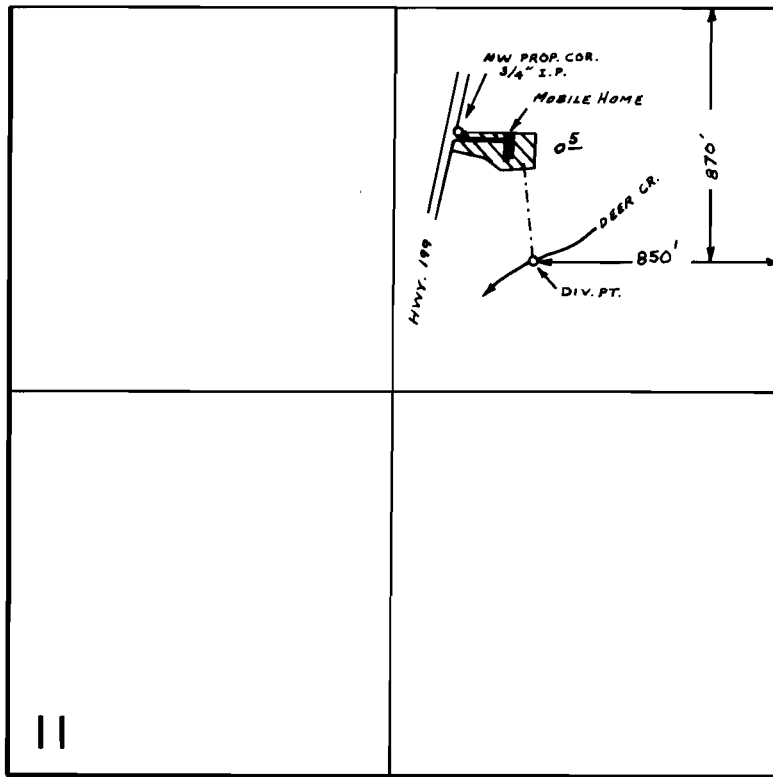

SCALE : 1" = 660 FT.

**FINAL PROOF SURVEY**  
UNDER

Application No. 47514 Permit No. 35585

IN NAME OF

BURL J. COX

Surveyed JUL. 19 78 by B. SUND