


T.37 S., R.8 W., W.M.

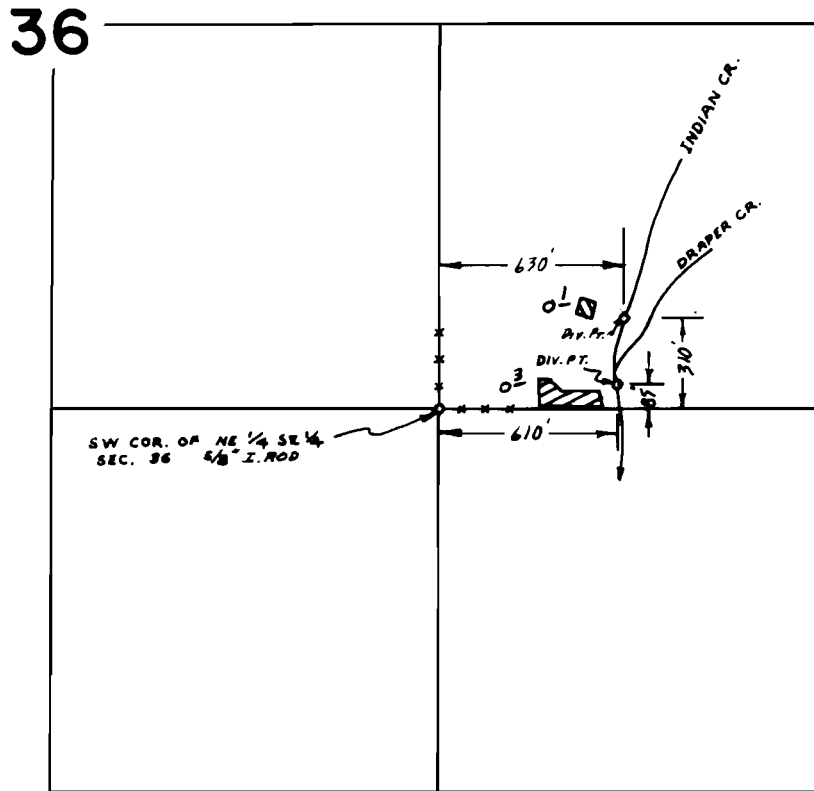

SCALE: 1" = 660 FT.

FINAL PROOF SURVEY
UNDER

Application No. 50638 Permit No. 37737
IN NAME OF

EDWIN F. KNOWLES, JR.

Surveyed JUL. 28 1978, by B. SUND