


T.38 S., R.8 W., W.M.

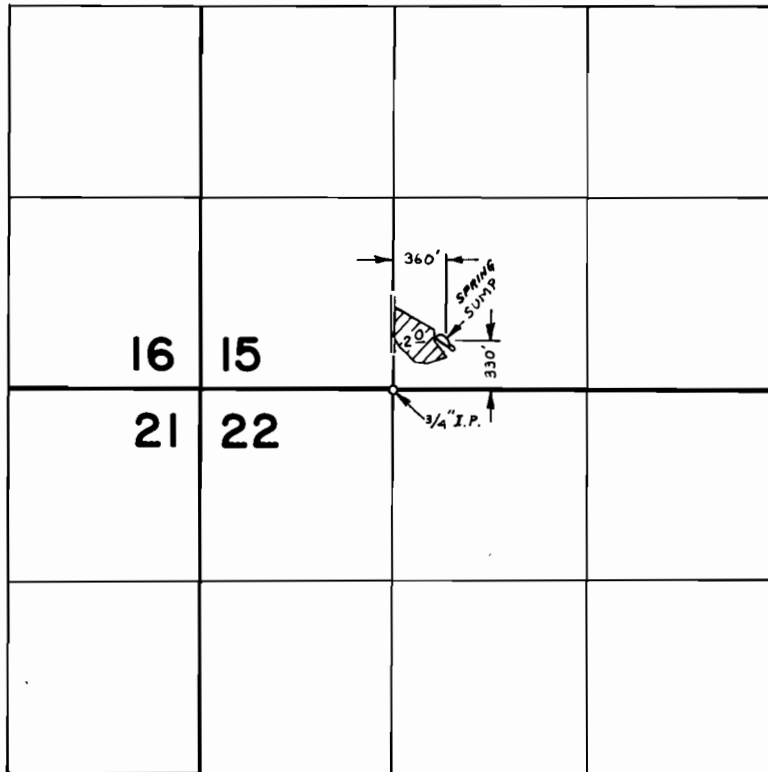

FINAL PROOF SURVEY UNDER

Application No. 50079 Permit No. 37906 SUPPL.

IN NAME OF

VINCENT D. BEAN

Surveyed OCT. 27 1978, by B. SUND