


T. 37 S., R. 7 W., W.M.

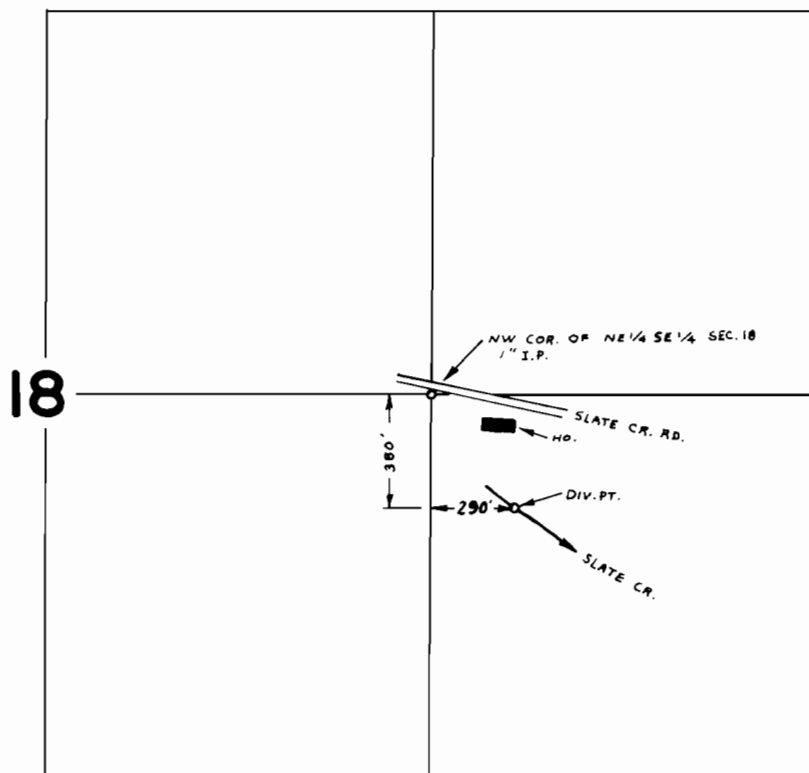

SCALE : 1" = 660 FT.

FINAL PROOF SURVEY
UNDER

Application No. 51955 Permit No. 39081
IN NAME OF

LAVERNE S. & FLORENCE S. CASTLE

Surveyed JUL. 27 1978, by B. SUND