


T.37S., R.7W., W.M.

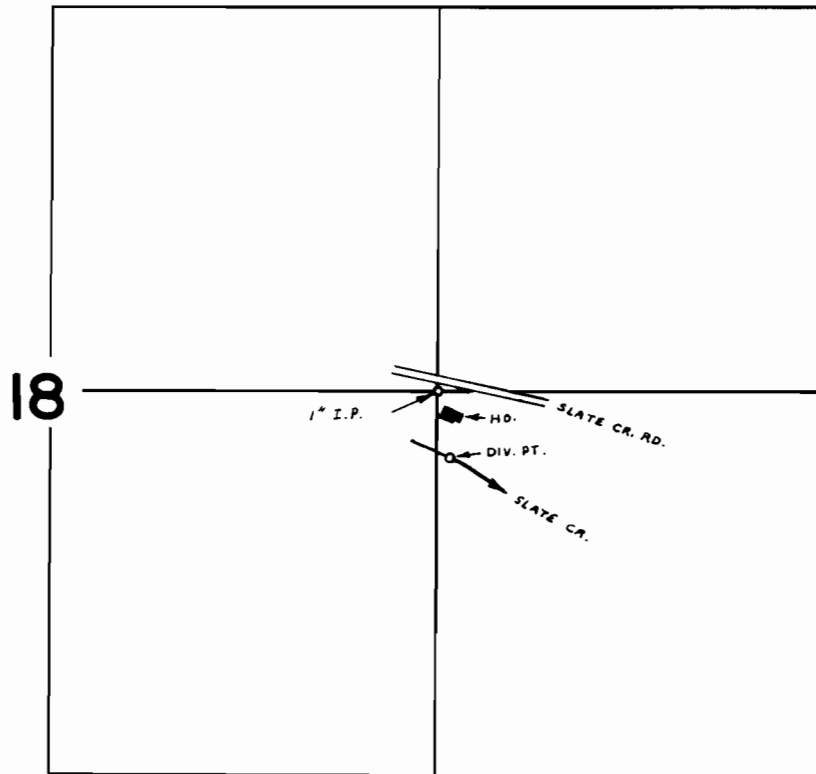

DIV. PT. LOC.: 230'S. & 50'E. FROM N.W. COR. OF NE 1/4 SE 1/4 SEC. 18

SCALE: 1" = 660 FT.

FINAL PROOF SURVEY
UNDER

Application No. 51966 Permit No. 39086
IN NAME OF

ROBERT SCOTT WILLIAMS

Surveyed JUL. 27 1978, by B. SUND