


# T. 38 S., R. 6 W., W. M.

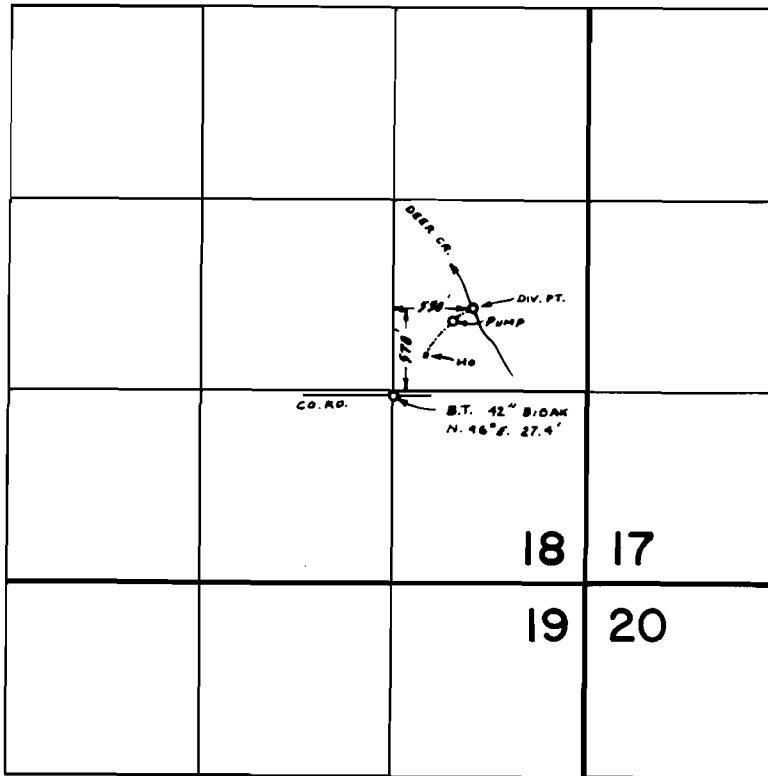

## FINAL PROOF SURVEY UNDER

Application No. 52254 Permit No. 39326  
IN NAME OF

TERRY CAIN

Surveyed JUL. 17 1978, by B. SUND