


T.39 S., R.7 W., W.M.

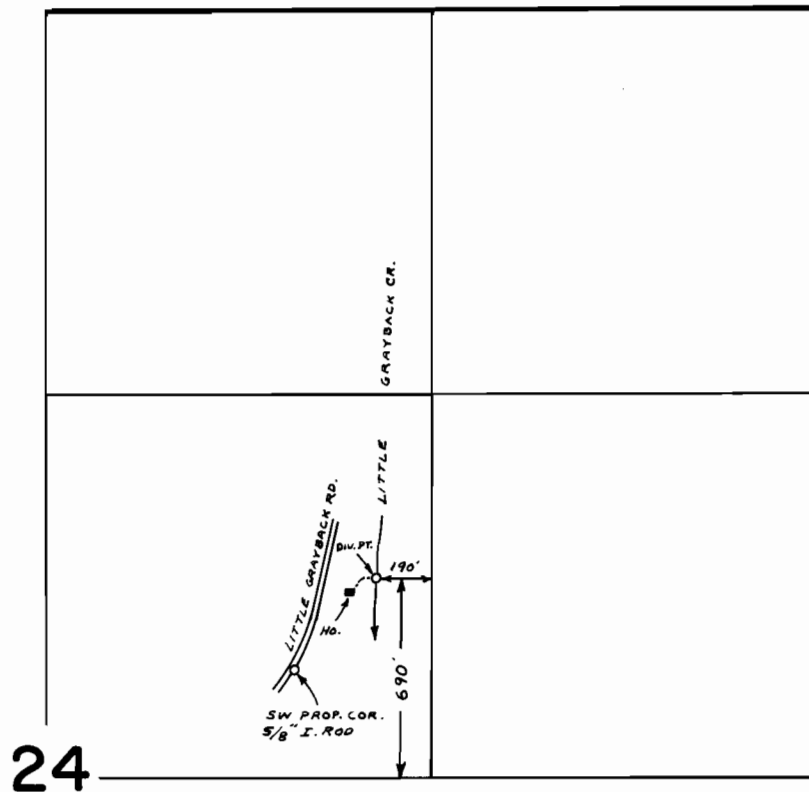

SCALE: 1" = 660 FT.

FINAL PROOF SURVEY
UNDER

Application No. 52398 Permit No. 39415
IN NAME OF

CHARLES & HOPE FRONTON

Surveyed AUG. 3 1978 by B. SUND