


T. 37 S., R. 6 W., W.M.

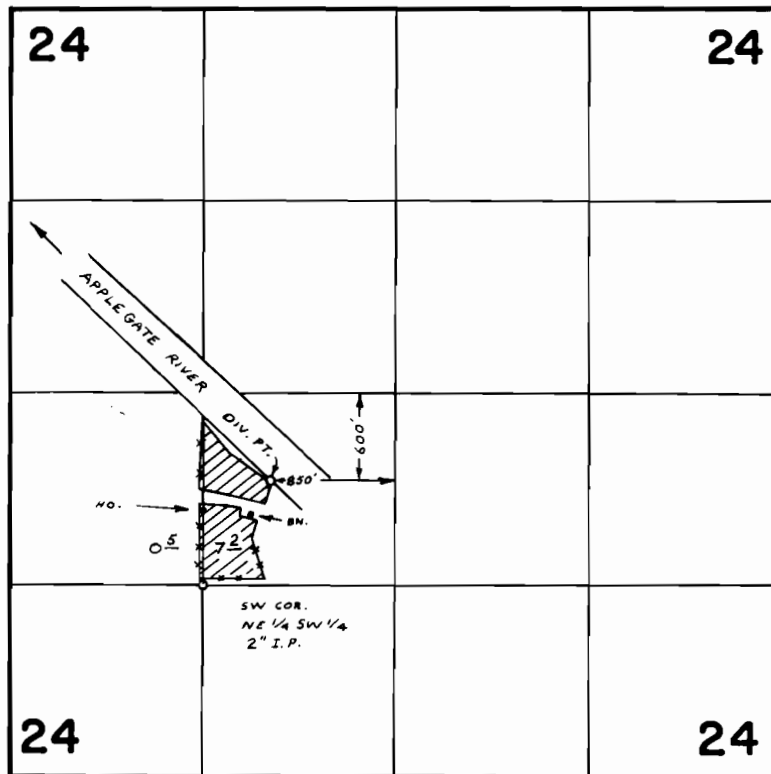

FINAL PROOF SURVEY UNDER

Application No. 52617 Permit No. 39669

IN NAME OF

MICHAEL W. & NANCY I. MEER

Surveyed OCT. 3 1978, by B. SUND