


T.37S.,R.5W.,W.M.

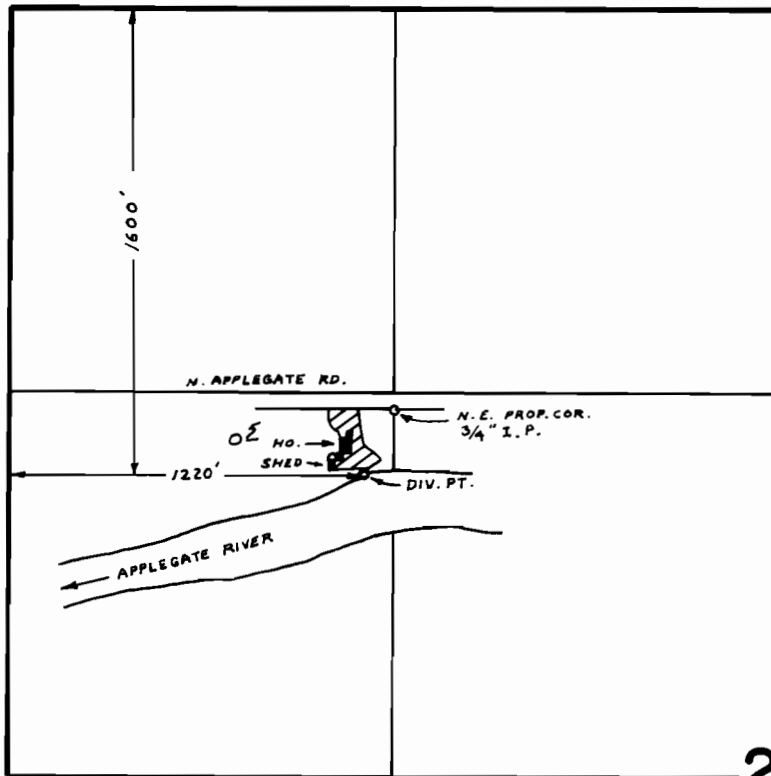

SCALE : 1" = 660 FT.

**FINAL PROOF SURVEY
UNDER**

Application No. 53837 Permit No. 40185
IN NAME OF

C. W. EILERT

Surveyed JUL. 14 1978, by B. SUND