


T. 36S., R. 5 W., W.M.

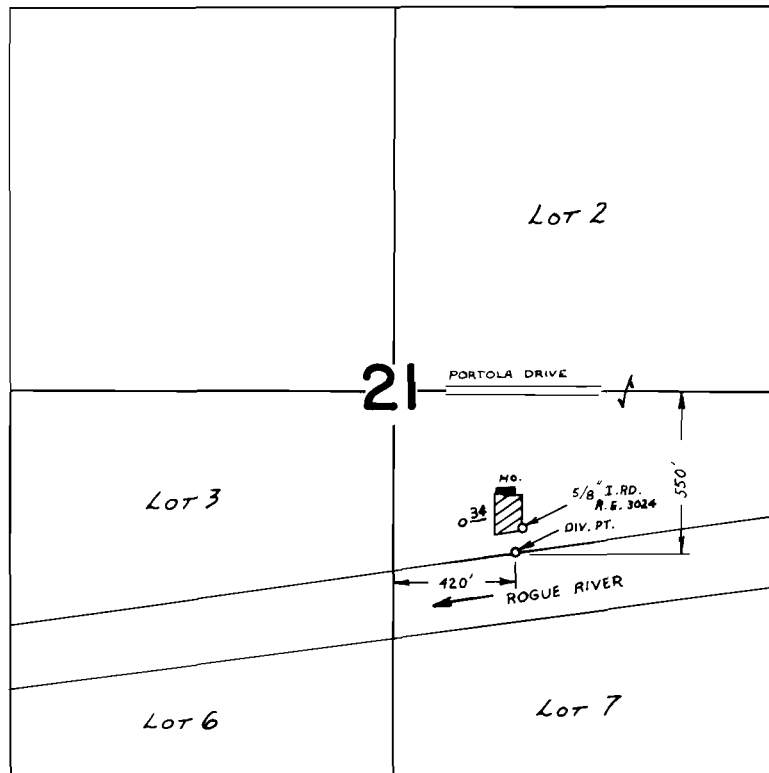

SCALE : 1" = 660 FT.

FINAL PROOF SURVEY
UNDER

Application No. 54374... Permit No. 40751...
IN NAME OF

ALFRED C. BRITTAIN

Surveyed JUN. 22 1978, by B. SUND