


T. 34 S., R. 6 W., W. M.

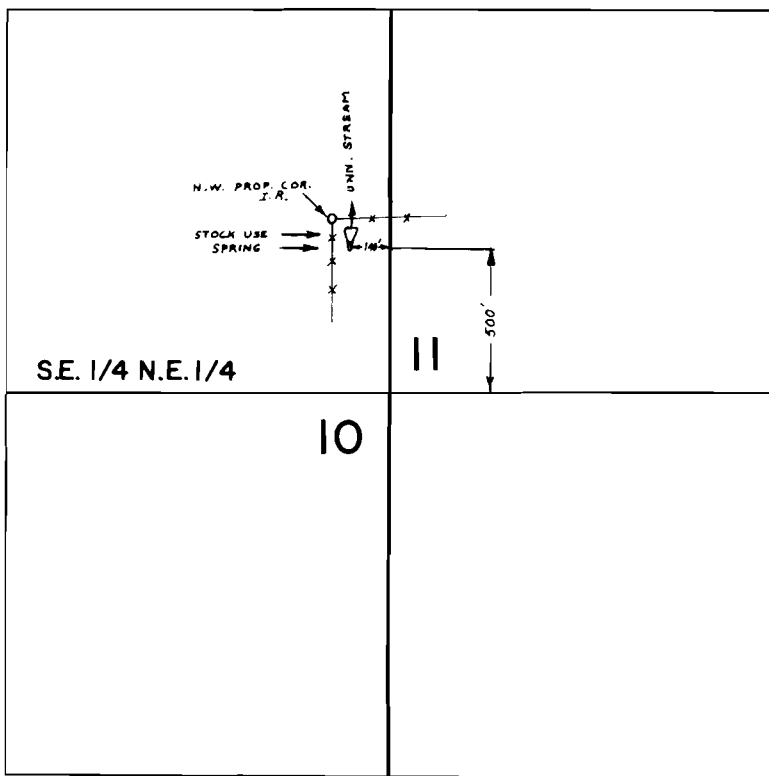

SCALE: 1" = 660 FT.

FINAL PROOF SURVEY
UNDER

Application No. 54466 Permit No. 40856
IN NAME OF

DAVID L. TRADER

Surveyed OCT. 25 1978, by B. SUND