


T. 36 S., R. 6 W., W.M.

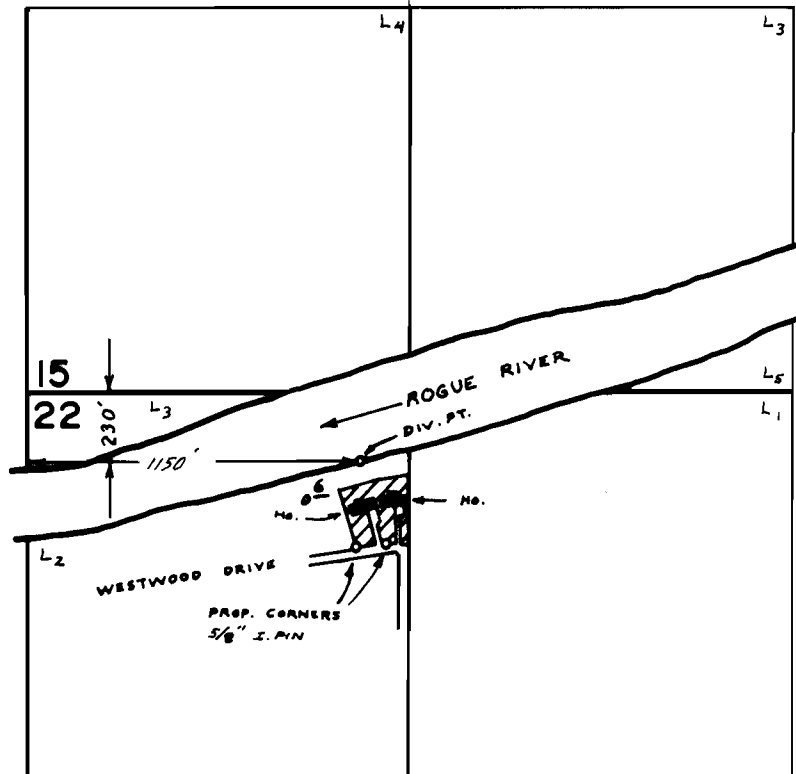

SCALE : 1" = 660 FT.

FINAL PROOF SURVEY
UNDER

Application No. 56414 Permit No. 42361
IN NAME OF
PAUL BELFORD

Surveyed JUN. 23, 1978, by B. SUND