


T.37S., R.7W., W.M.

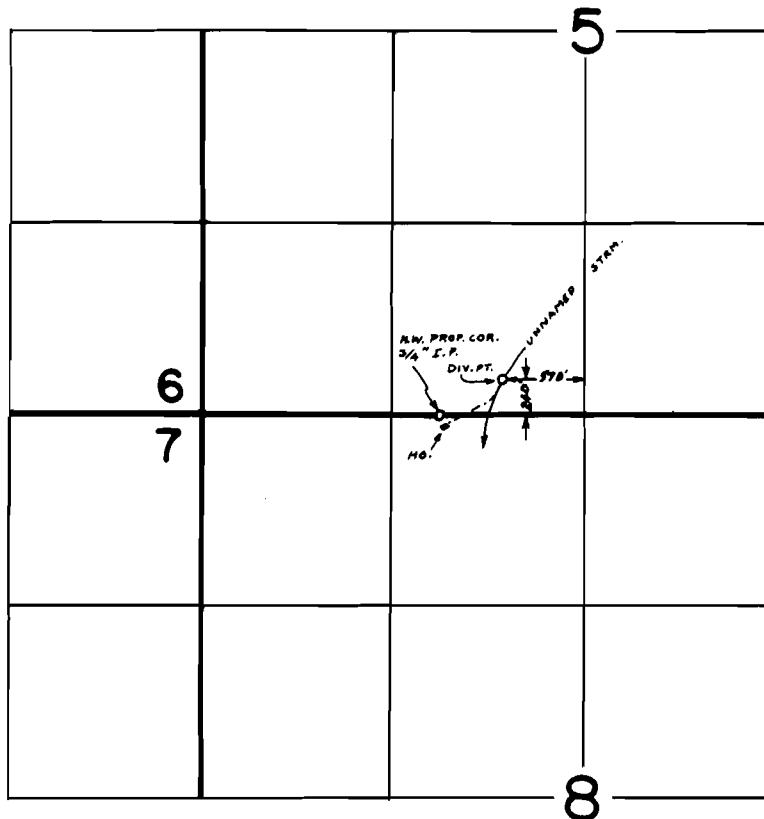

FINAL PROOF SURVEY
UNDER

Application No. 56364 Permit No. 42363
IN NAME OF

ROBIN MORANETZ

Surveyed JUL. 27 1978, by B. SUND