


T. 36 S., R. 5 W., W.M.

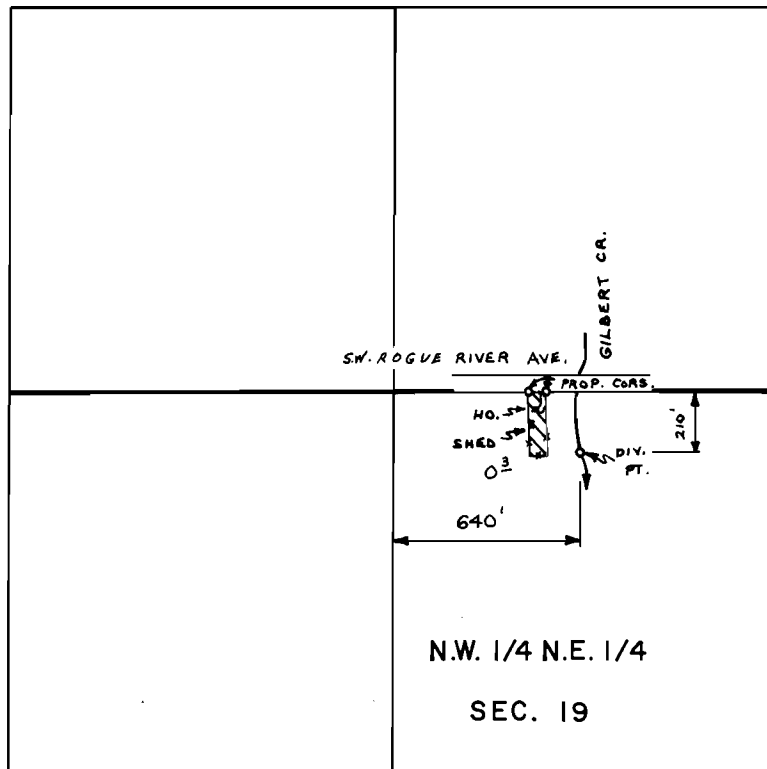

SCALE : 1" = 660 FT.

**FINAL PROOF SURVEY**  
UNDER

Application No. 56674 Permit No. 42549  
IN NAME OF

VICTOR NIELSEN

Surveyed OCT. 23 1978, by B. SUND

D.H.M.

P.T.S. - 1978 - 14 - D