


# T.36S.,R.5W.,W.M.

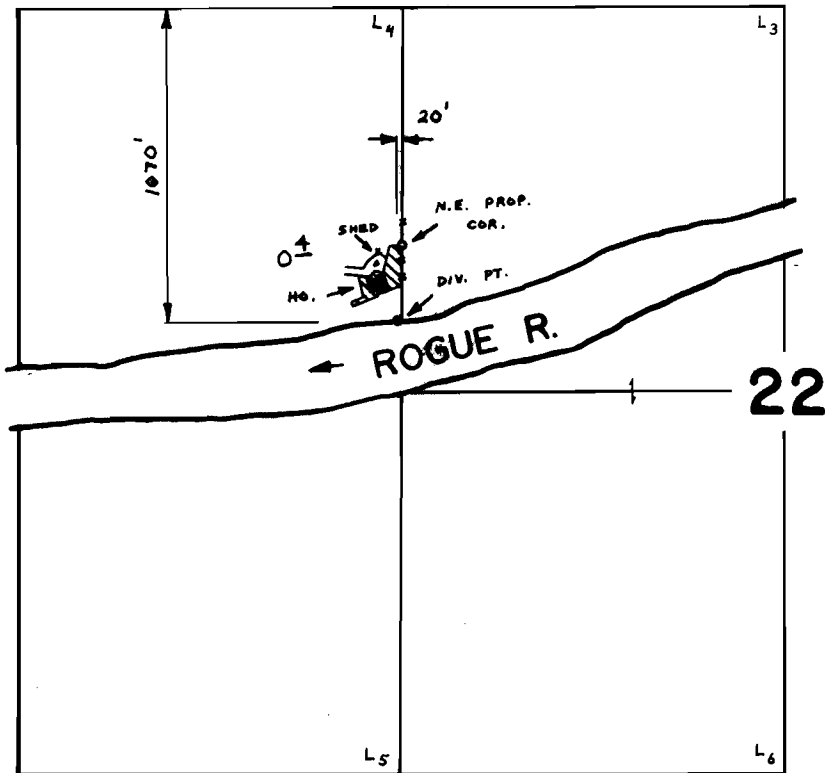

SCALE: 1" = 660 FT.

## FINAL PROOF SURVEY UNDER

Application No. 57043 Permit No. 42740  
IN NAME OF

..... THERON A. CROREY .....

Surveyed JUN. 22 1978, by B. SUND .....

D.H.M.  
P.T.S. - 1978 - 14 - A