


T16S. R5W. WM.

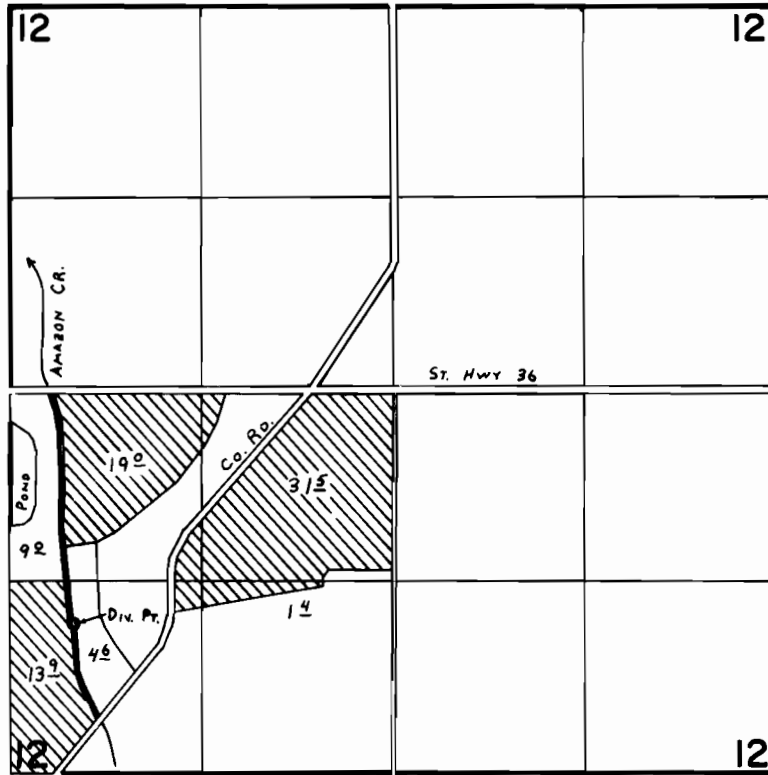

DIV. PT. LOC: 1030' N. & 440' E. fr. S.W. COR. SEC. 12.

FINAL PROOF SURVEY

UNDER

Application No. 49747 Permit No. 37304
IN NAME OF

EVERETT FALK

Surveyed JUNE 15 1978, by C. L. HUGHES