


T17S. R2W. WM.

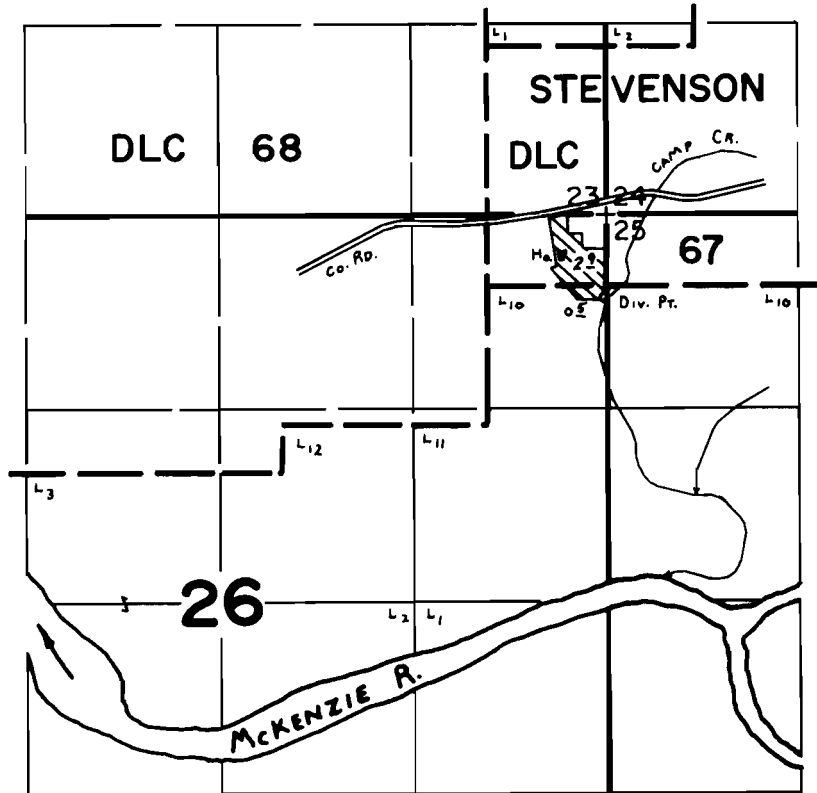

Div. Pt. Loc: 570' S. & 10' W. fr. N.E. Cor. Sec. 26.

FINAL PROOF SURVEY UNDER

Application No. 56195... Permit No. 42243...

IN NAME OF

JOHN & COLLEEN M. MCGINTY

Surveyed JULY 17, 1978, by C. L. HUGHES...