


T13S. R3W. WM.

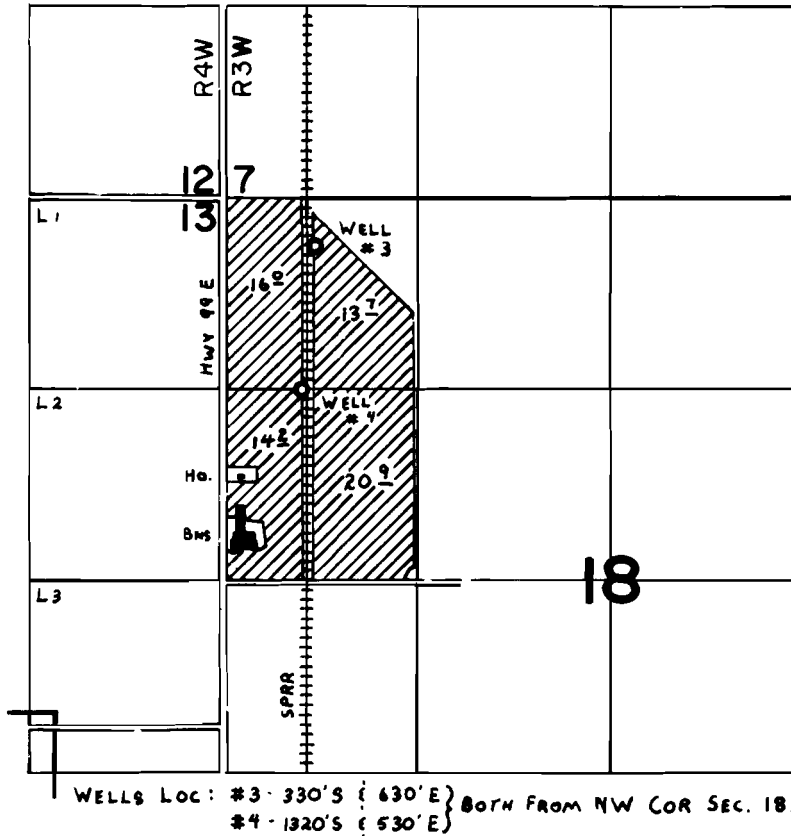

FINAL PROOF SURVEY
UNDER

Application No. G-5700 Permit No. G-5509
IN NAME OF

J. W. & HAZEL JEAN PUGH

Surveyed MAY 4 1978, by C. L. HUGHES