


T.2N., R.9W., W.M.

SEC. 7

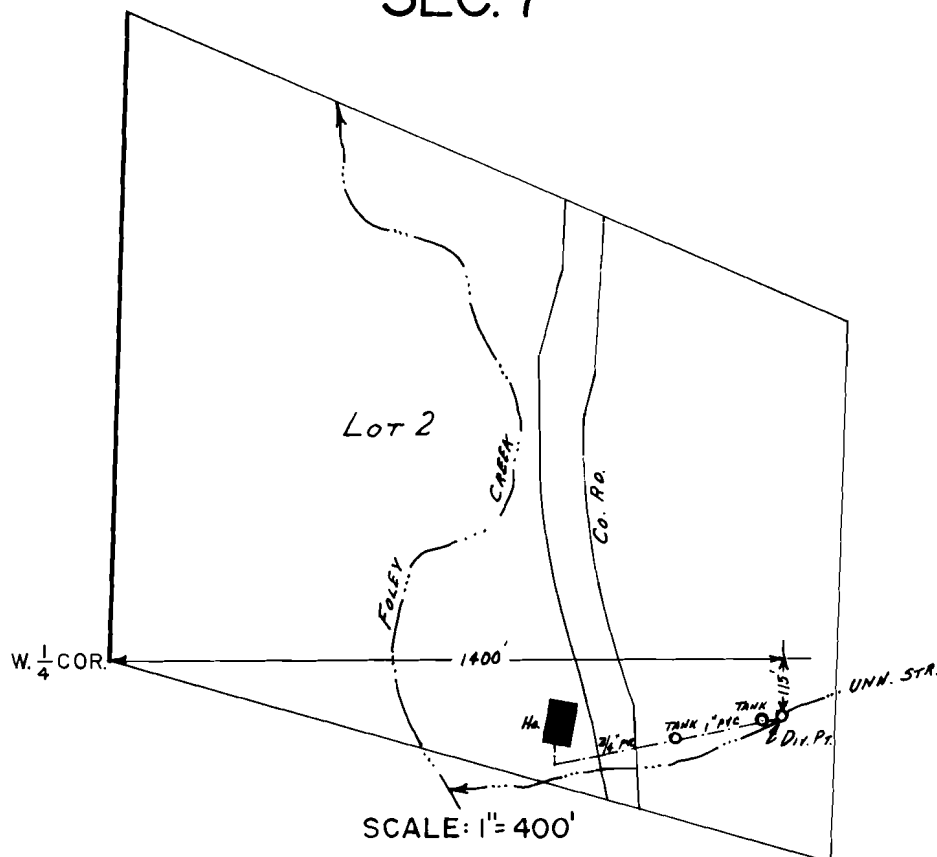

**FINAL PROOF SURVEY**  
UNDER

Application No. 57231... Permit No. 42986...  
IN NAME OF

STANLEY M. & ESTHER F. PACE...

Surveyed Sept. 13... 1978, by C.L. HUGHES.....