


T.48&5S. R.38&4W. W.M.

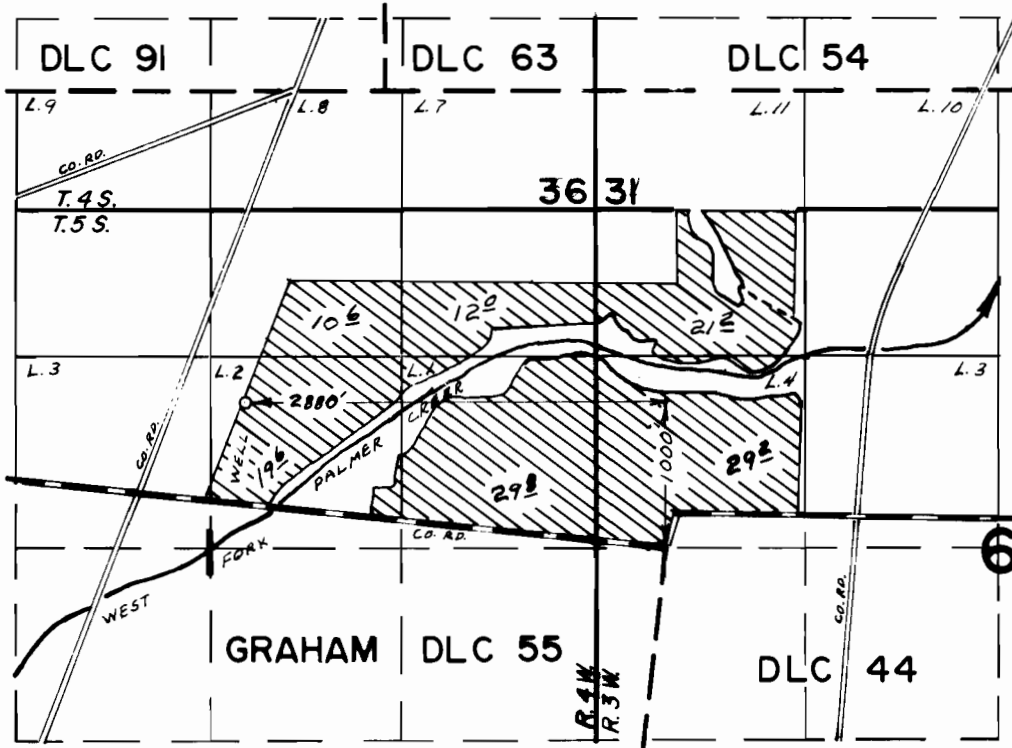

FINAL PROOF SURVEY UNDER

Application No. G-6219 Permit No. G-5873
IN NAME OF

GARY A. CRUICKSHANK

Surveyed MAR. 10. 1978. by L.H. NUNN