


T.6S. R.4W. W.M.

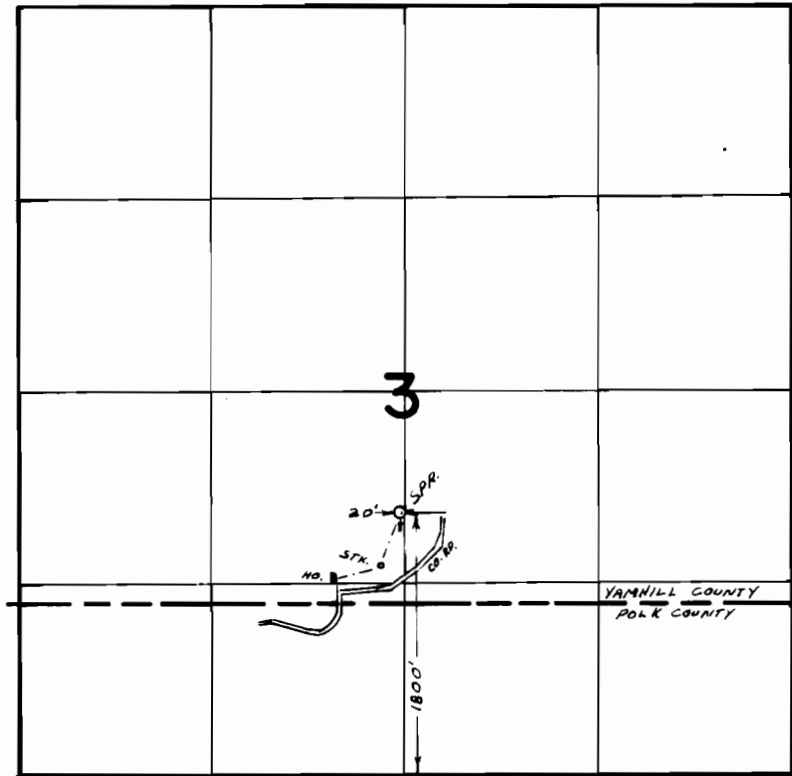

FINAL PROOF SURVEY UNDER

Application No. 49188... Permit No. 36874...
IN NAME OF

.....E.F. McMULLEN.....

Surveyed MAR. 21. 1978., by L.H. NUNN.....