


T.6S. R.5W. W.M.

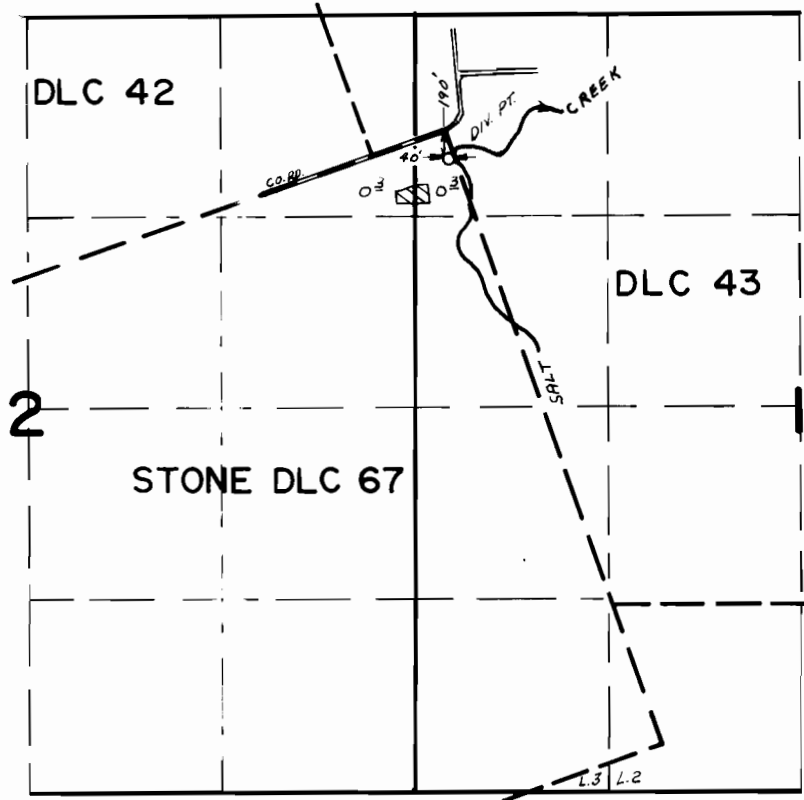

FINAL PROOF SURVEY UNDER

Application No. 52992 Permit No. 39999
IN NAME OF
CORBETT H. DOWNING
SAM COULSTON & ANTON WALAKER

Surveyed MAR. 14. 1978, by L.H. NUNN