


# T. 5S., R. 5W., W.M.

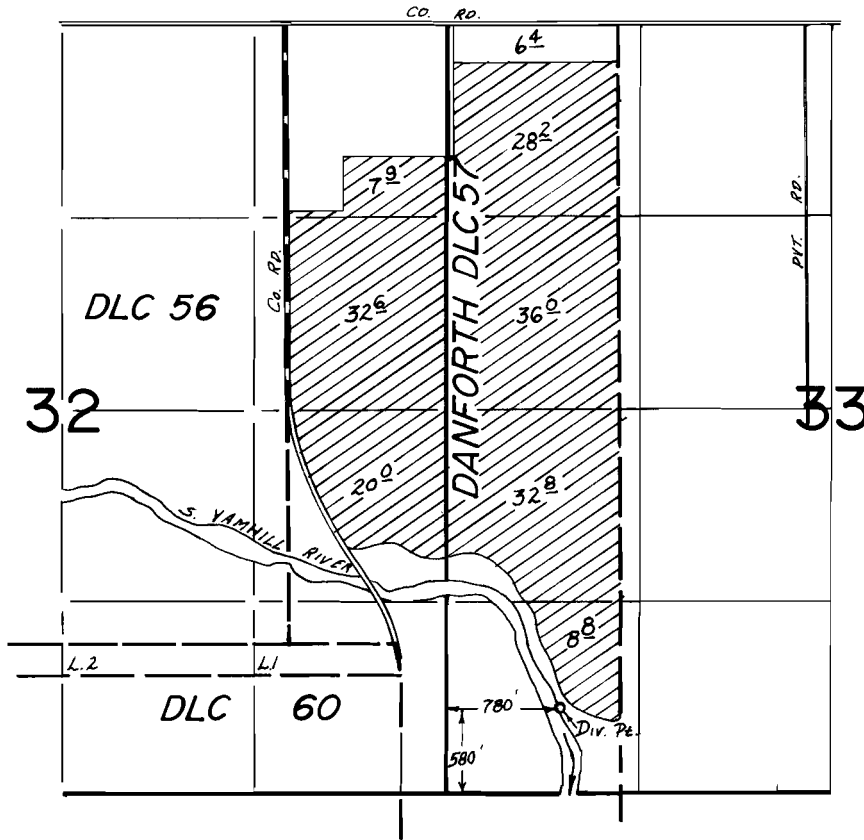

## FINAL PROOF SURVEY UNDER

Application No. 53042..... Permit No. 40030.....  
IN NAME OF

JOHN DeJONG

Surveyed MARCH 14, 1978, by L.H. NUNN.....