


# T.5S.R.7W.W.M.

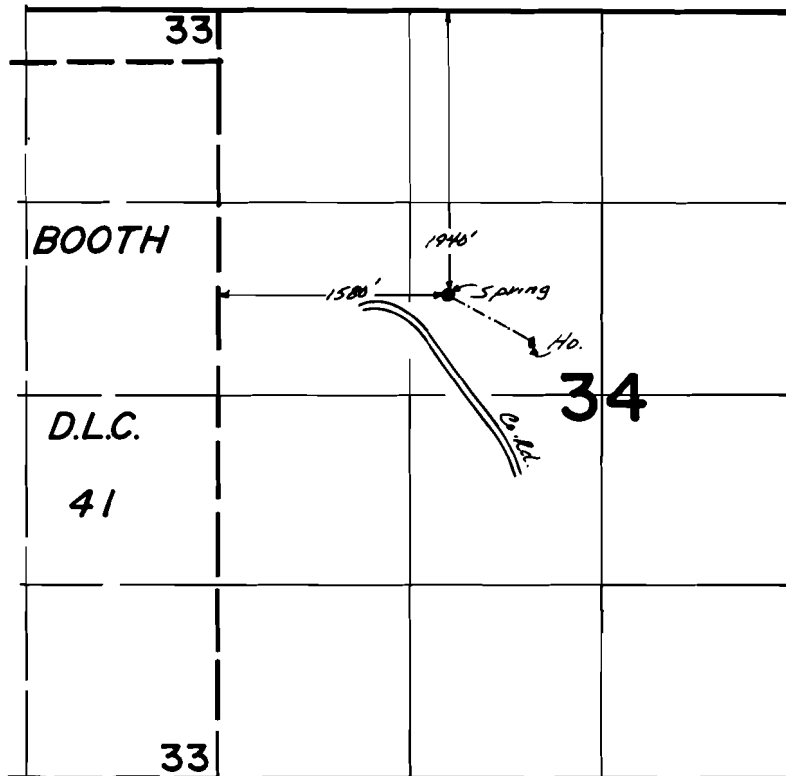

## FINAL PROOF SURVEY UNDER

Application No. 53990... Permit No. 40261...  
IN NAME OF

.....NILO KOIVU.....

Surveyed March 17 1978, by L.H.Nunn.....