


T5S. R8W. WM.

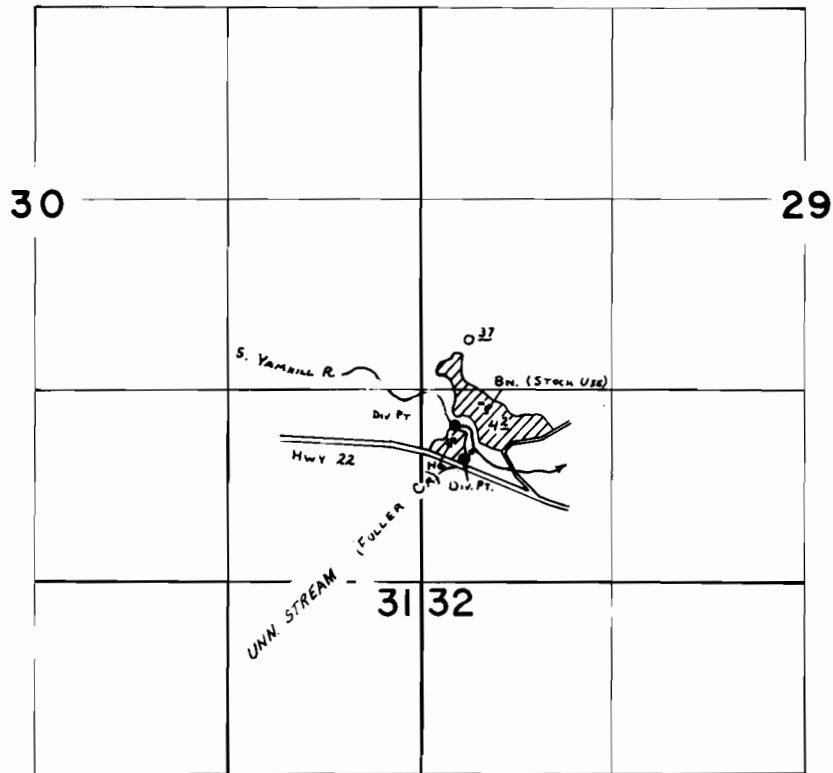

DIV PT RIVER: 1080' N } 230' E } both fr. SW COR SEC 29.
 DIV PT STREAM: 850' N } 290' E }

FINAL PROOF SURVEY UNDER

Application No. 52924 Permit No. 40296
 IN NAME OF

EDWARD EARL ENGEL

Surveyed SEPT 7 1978, by C. L. HUGHES