


T.5S. R.6W. W.M.

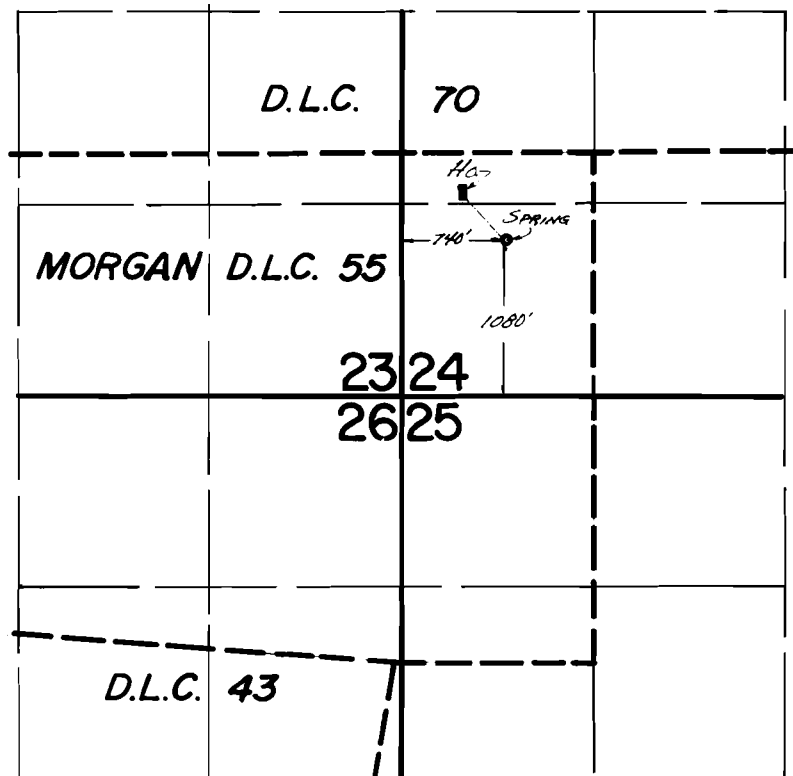

FINAL PROOF SURVEY
UNDER

Application No. 547.97... Permit No. 411.13.....
IN NAME OF

.....ALVIN G. KELSON.....

Surveyed March.17. 1978., by L.H. Nunn.....