


# T. 11S. R. 4W. W.M.

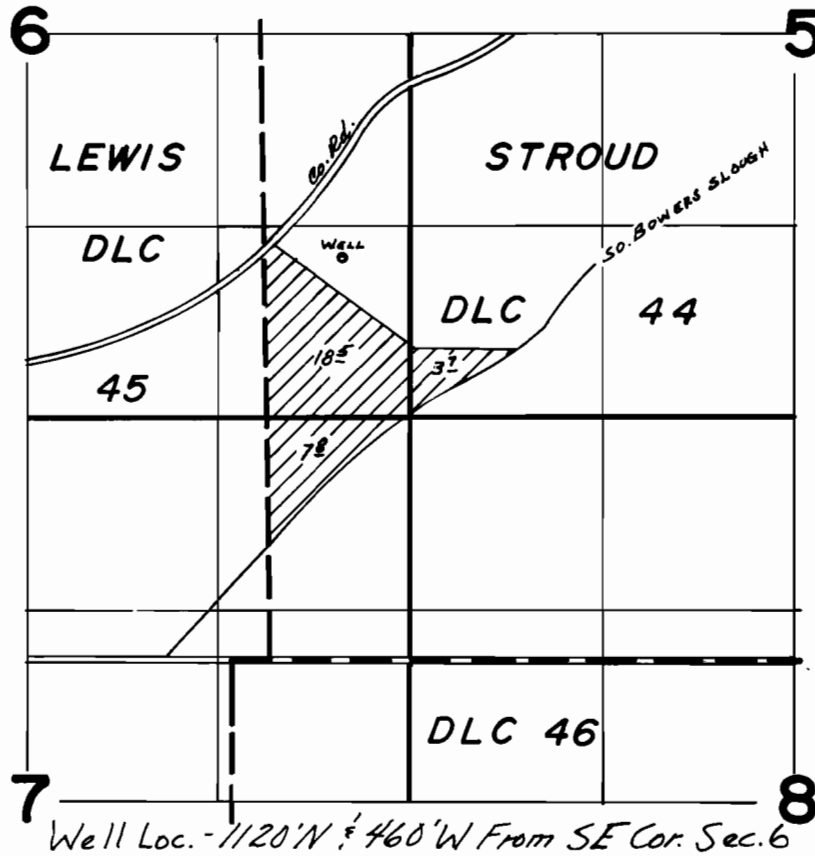

## FINAL PROOF SURVEY UNDER

Application No. G-7736 Permit No. G-7175...  
IN NAME OF

.....HECTOR FARMS, INC.....

Surveyed April 11, 1978, by J.S. Donaldson...