


T. 13S. R. 6W. W.M.

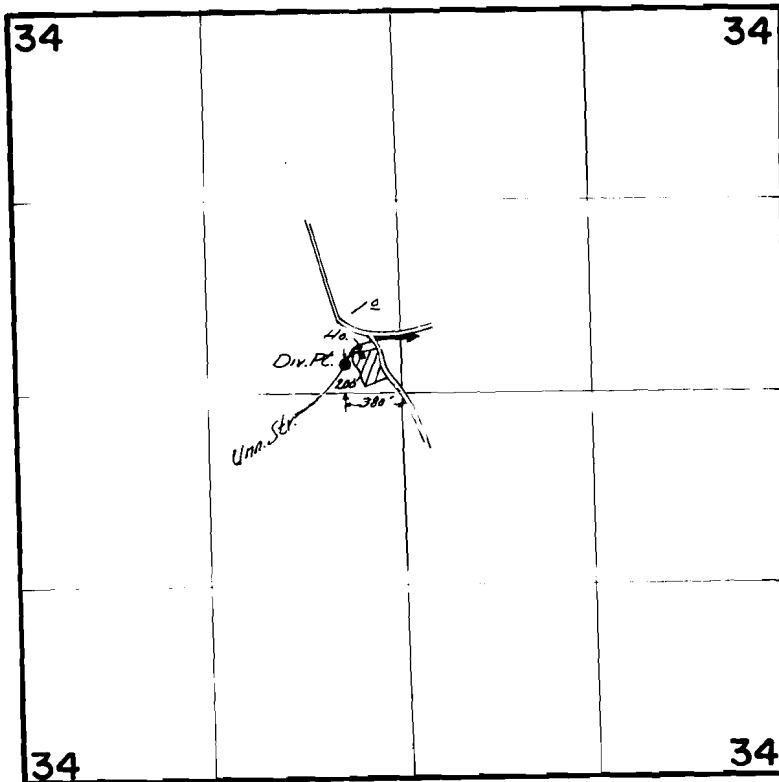

**FINAL PROOF SURVEY**  
UNDER

Application No. 57259 Permit No. 43082...  
IN NAME OF

.....NILE J. PEARCE.....

Surveyed Oct. 4, 1978, by S.P. Applegate...