


# T3S. RIE. WM.

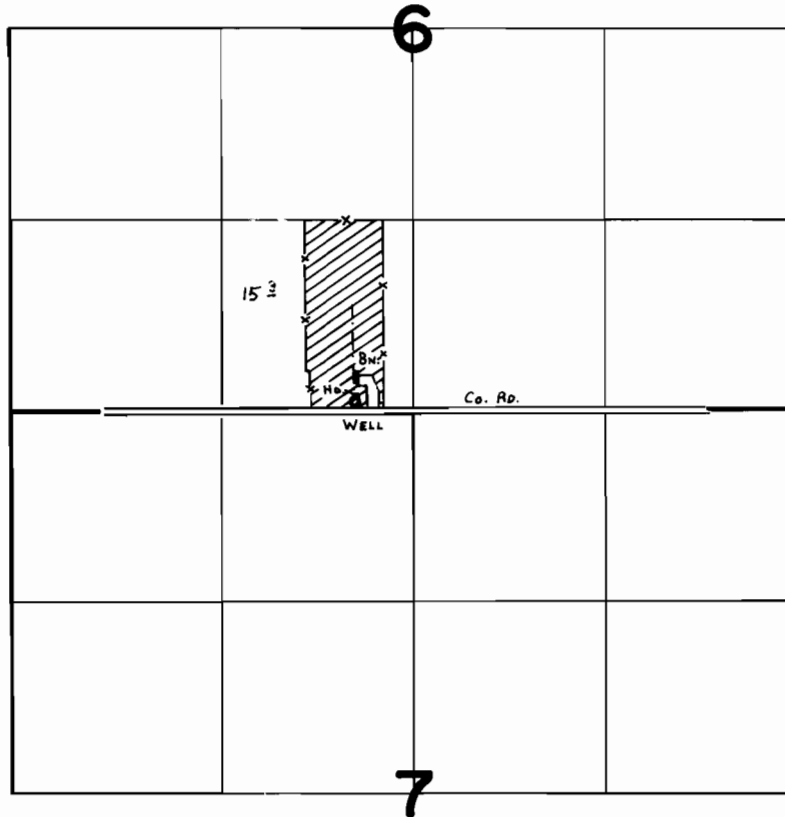

WELL LOC: 60' N. & 400' W. FR. S. 1/4 COR. SEC. 6.

## FINAL PROOF SURVEY UNDER

Application No. G-7103 Permit No. G-6568  
IN NAME OF

H. CRAIG EBY

Surveyed JUNE 8 1978, by C. L. HUGHES