


T. 5S. R. 3E. W.M.

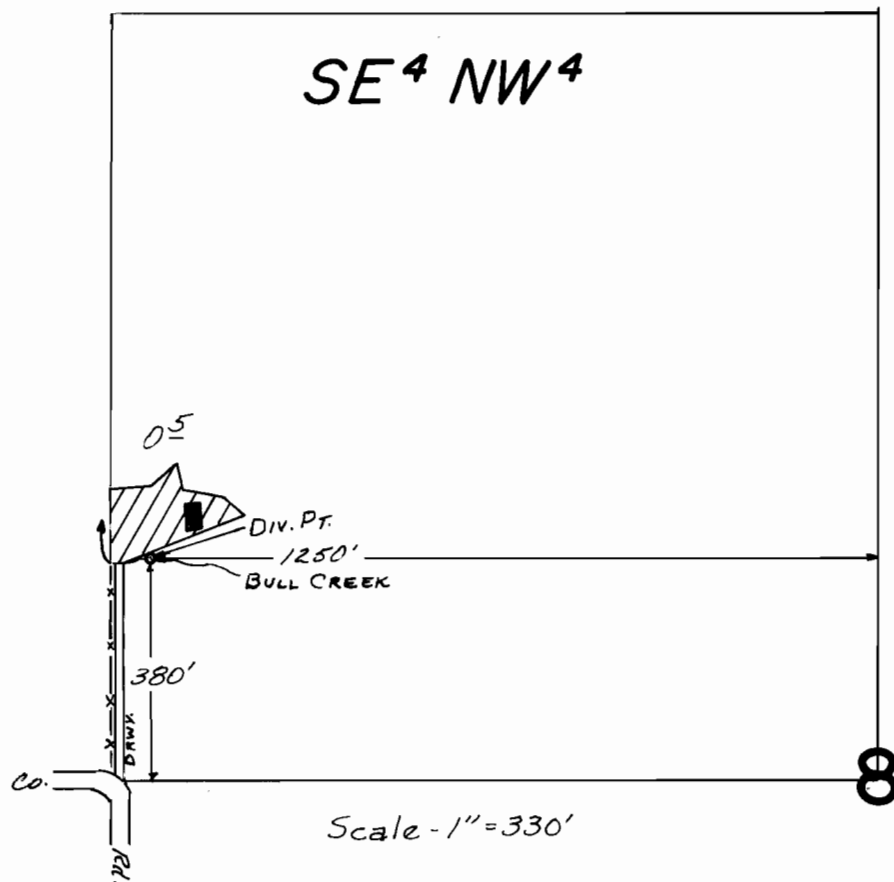

FINAL PROOF SURVEY
UNDER

Application No. 51018 Permit No. 37815
IN NAME OF

ELLIS & RACHEL MILTON

Surveyed MAY 3 1978 by J.S. Donaldson