


T. 5S. R. 1E. W.M.

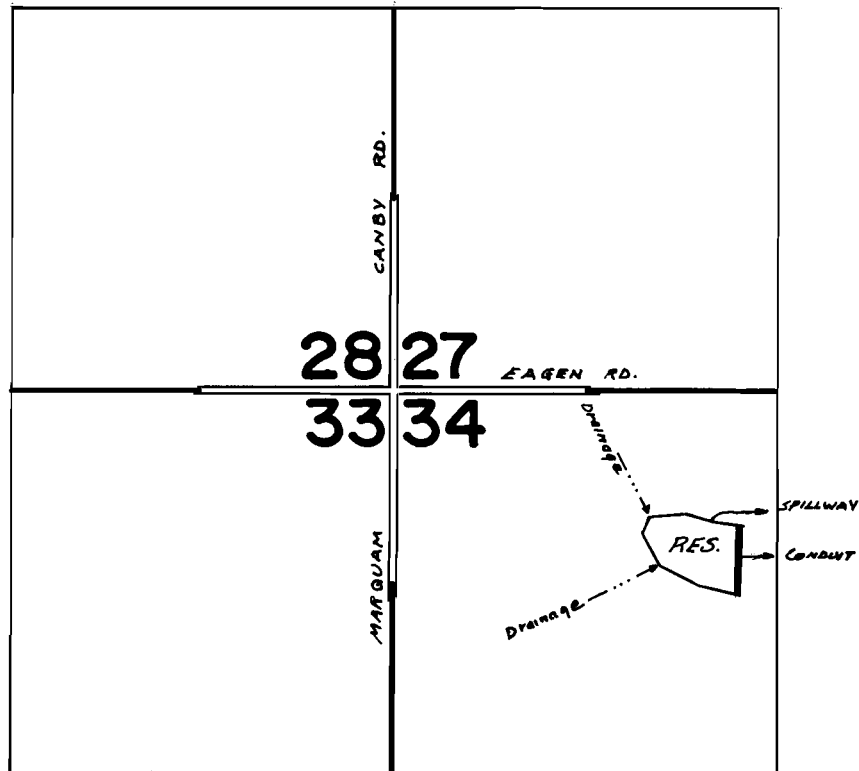

Scale - 1" = 660'

FINAL PROOF SURVEY
UNDER

Application No. R-53000 Permit No. R-639.4
IN NAME OF

GERALD JAMES

Surveyed MAY 3 1978 by J.S. Donaldson