


T.32S. R.6W. W.M.

Sec. 31

SE1/4 NE1/4

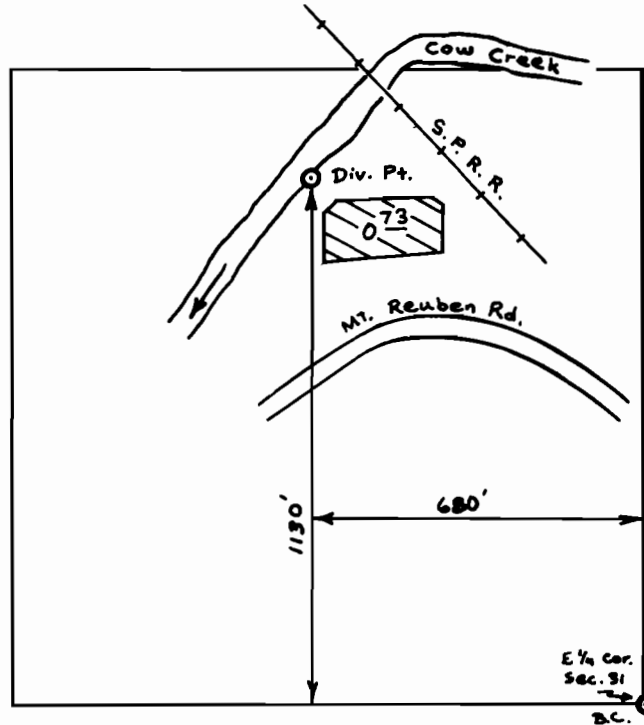

SCALE: 1" = 400'

FINAL PROOF SURVEY
UNDER

Application No. 51634 Permit No. 38938
IN NAME OF

PETER C. JARNES

Surveyed Jan. 22, 1979, by S. Donaldson