

T.31S. R.6W. W.M.

Sec. 2

N1/2 NW 1/4

34 | 35


3

2

Lot 4

T. 306.
T. 31 S.

Lot 3

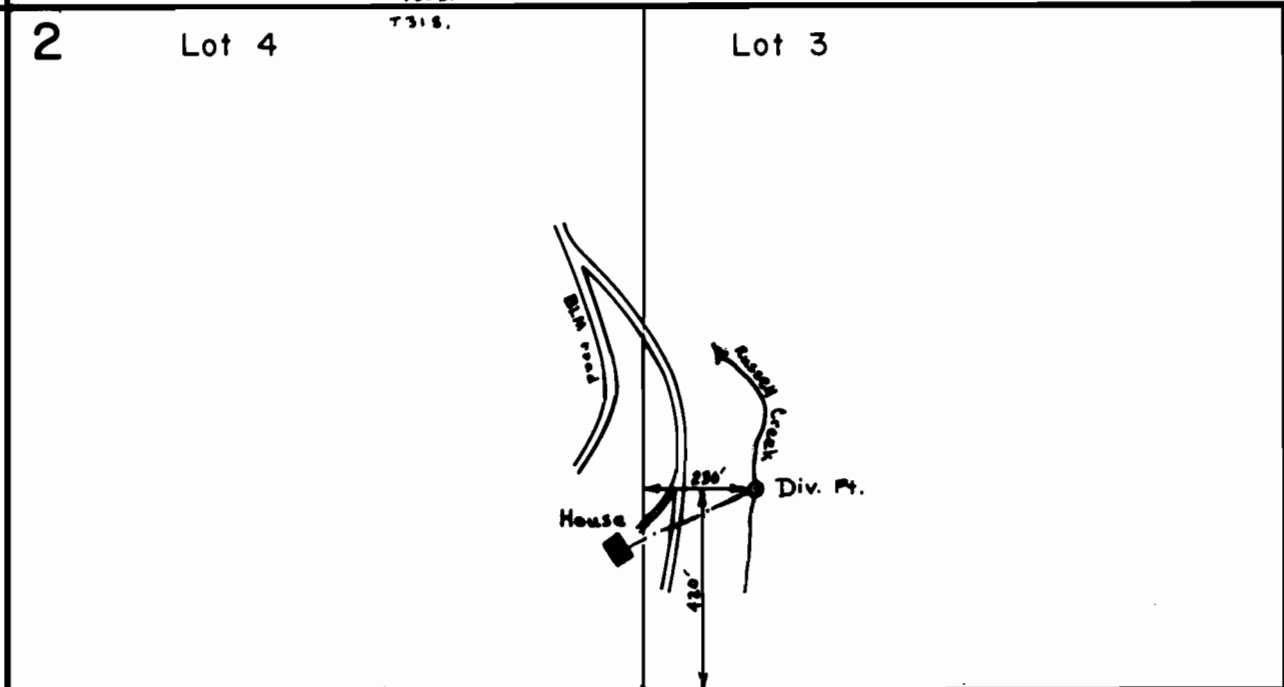

SCALE: 1" = 400'

FINAL PROOF SURVEY
UNDER

Application No. 54670 Permit No. 41019
IN NAME OF

James E. & Marilyn A. Hall

Surveyed Oct. 5 1977, by D. Sparks