


T. 29 S., R. 6 W., W.M.

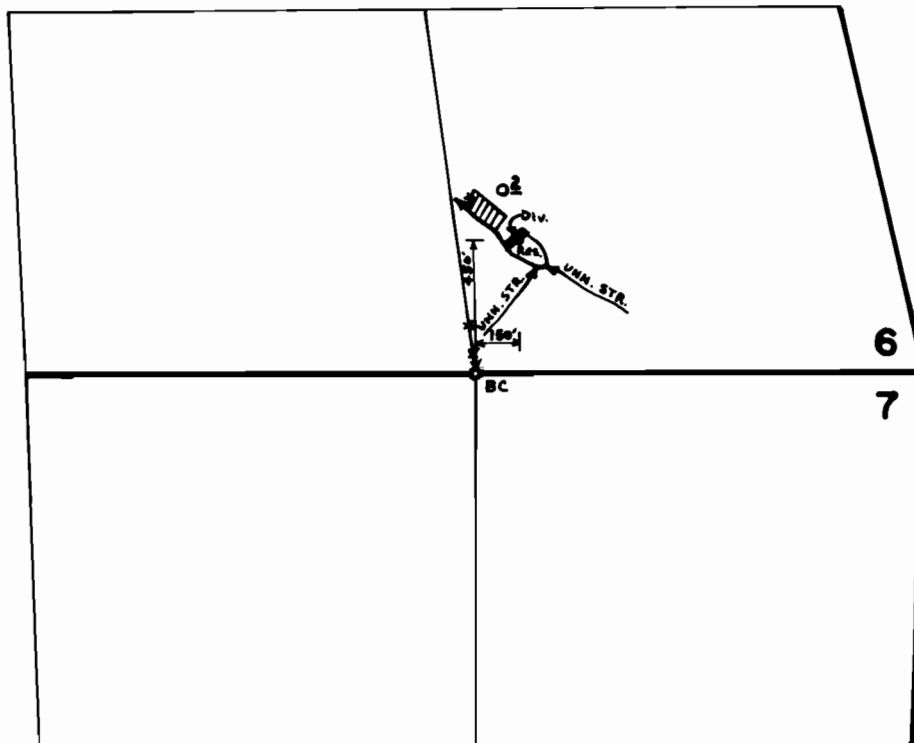

SCALE: 1" = 660'

FINAL PROOF SURVEY
UNDER

R-51212 R-6212
Application No. 51213 Permit No. 38694
IN NAME OF

RAY G. McALPINE

Surveyed MAR. 3 1978, by D.W. SPARKS