


T9S. R27E. WM.

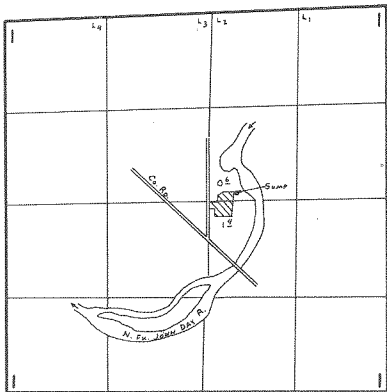

Sump Loc: 100' N. (400' E fr. C. 1/4 Cor. Sec. 1

FINAL PROOF SURVEY
UNDER

Application No. G-8497 Permit No. G-7818.....
 IN NAME OF

L. D. WALTER VINSON.....

Surveyed June...10... 1978., by J. S. DONALDSON

C-50277