


37898
C-50278

T. 9S. R. 26E. W.M.

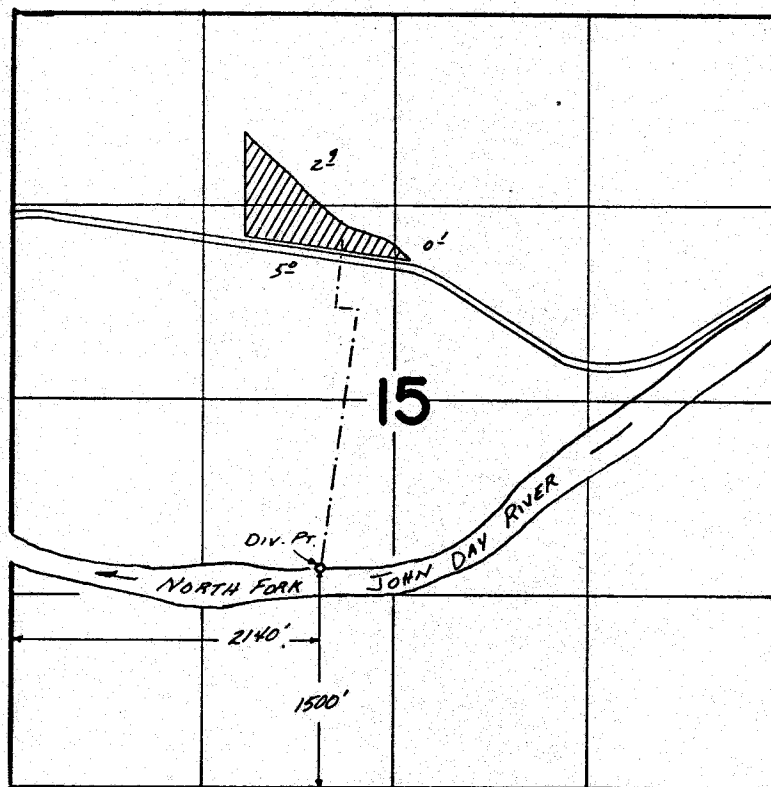

FINAL PROOF SURVEY UNDER

Application No. 49868... Permit No. 37898
IN NAME OF

.....WILBURN WILLIAMS.....

Surveyed Aug. 29, 1978, by J.S. Donaldson....

C-50278