


RECEIVED
JUL 3 1975
WATER RESOURCES DEPT.
SALEM, OREGON

RECEIVED
MAY 9 1975
STATE ENGINEER
SALEM, OREGON

139588

SW 1/4 SW 1/4 SEC. 22 T. 13 S. R. 31 E. W.M.

C 10279
NO Street map

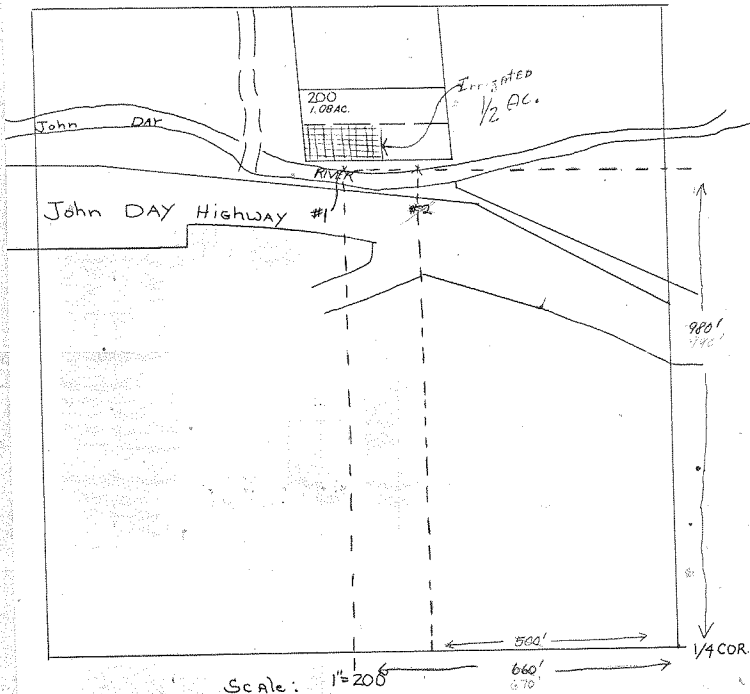

Application No. 53106
Permit No. 38588