


T. 9 & 10 S. R. 29 E. W. M.

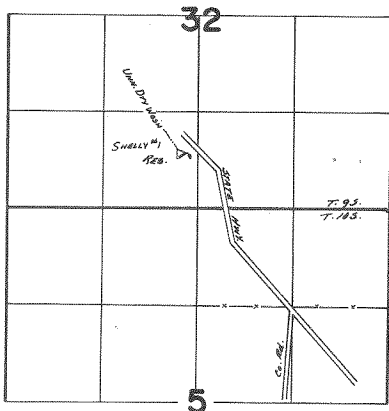

FINAL PROOF SURVEY
UNDER

Application No. R-48835 Permit No. R-5924.
IN NAME OF

..... MRS. MYRTLE SHELLEY

Surveyed Aug. 29 1978, by J.S. Donaldson.