


T.23S. R.34E. W.M.

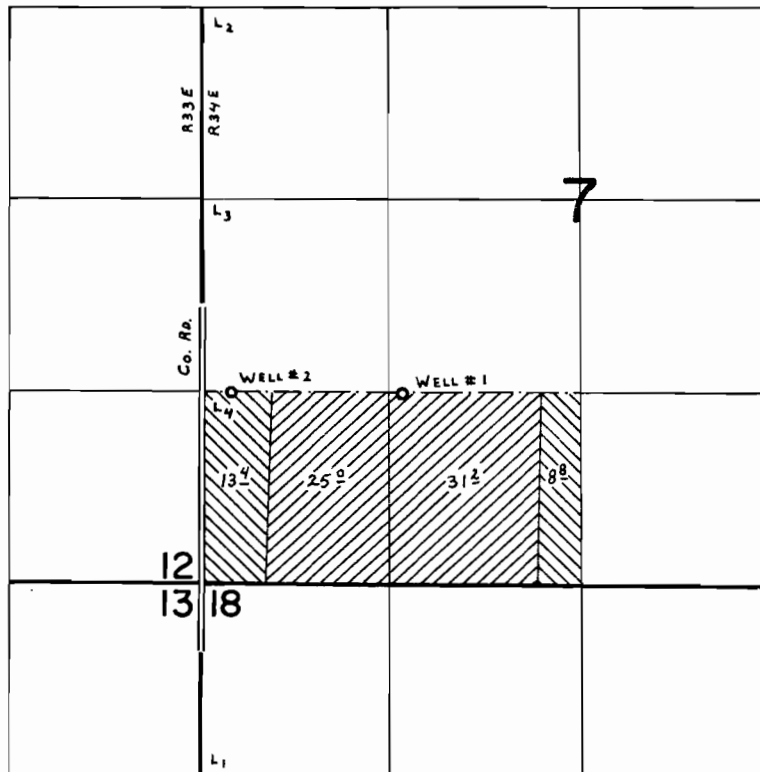

WELLS LOC: #1- 1320' N. & 1380' E. } BOTH FROM S.W. COR. SEC. 7.
#2- 1320' N. & 200' E. }

- ▨ - PRIMARY IRR. WELL #1 (APP. G-8330); SUPPLEMENTAL IRR. WELL #2 (APP. G-8331)
▨ - SUPPLEMENTAL IRR. WELL #2 (APP. G-8331)

FINAL PROOF SURVEY UNDER

Application No. G-8330 Permit No. G-8190
G-8331 G-8151
IN NAME OF

WILLIAM C. GEHRKE

Surveyed Aug. 29, 1978, by C. L. HUGHES