


T.23S. R.34E. W.M.

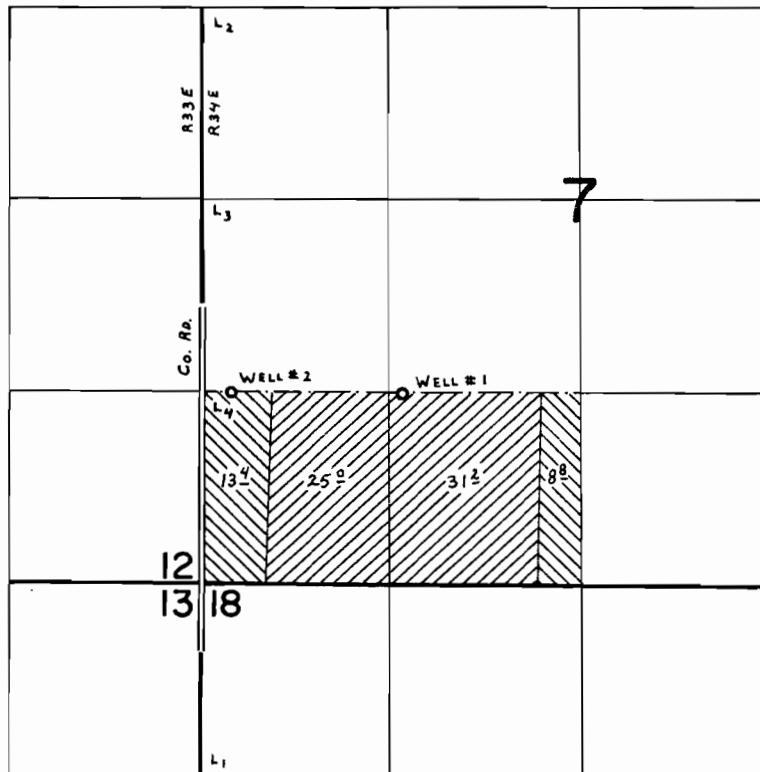

WELLS LOC: #1- 1320' N. & 1380' E. } BOTH FROM S.W. COR. SEC. 7.
 #2- 1320' N. & 200' E. }

- [Hatched Box] - PRIMARY IRR. WELL #1 (APP. G-8330); SUPPLEMENTAL IRR. WELL #2 (APP. G-8331)
 [Hatched Box] - SUPPLEMENTAL IRR. WELL #2 (APP. G-8331)

FINAL PROOF SURVEY

UNDER

Application No. G-8330 Permit No. G-8190
 IN NAME OF

WILLIAM C. GEHRKE

Surveyed Aug. 29, 1978, by C. L. HUGHES