


# T.10S. R.12 & 13E. W.M.

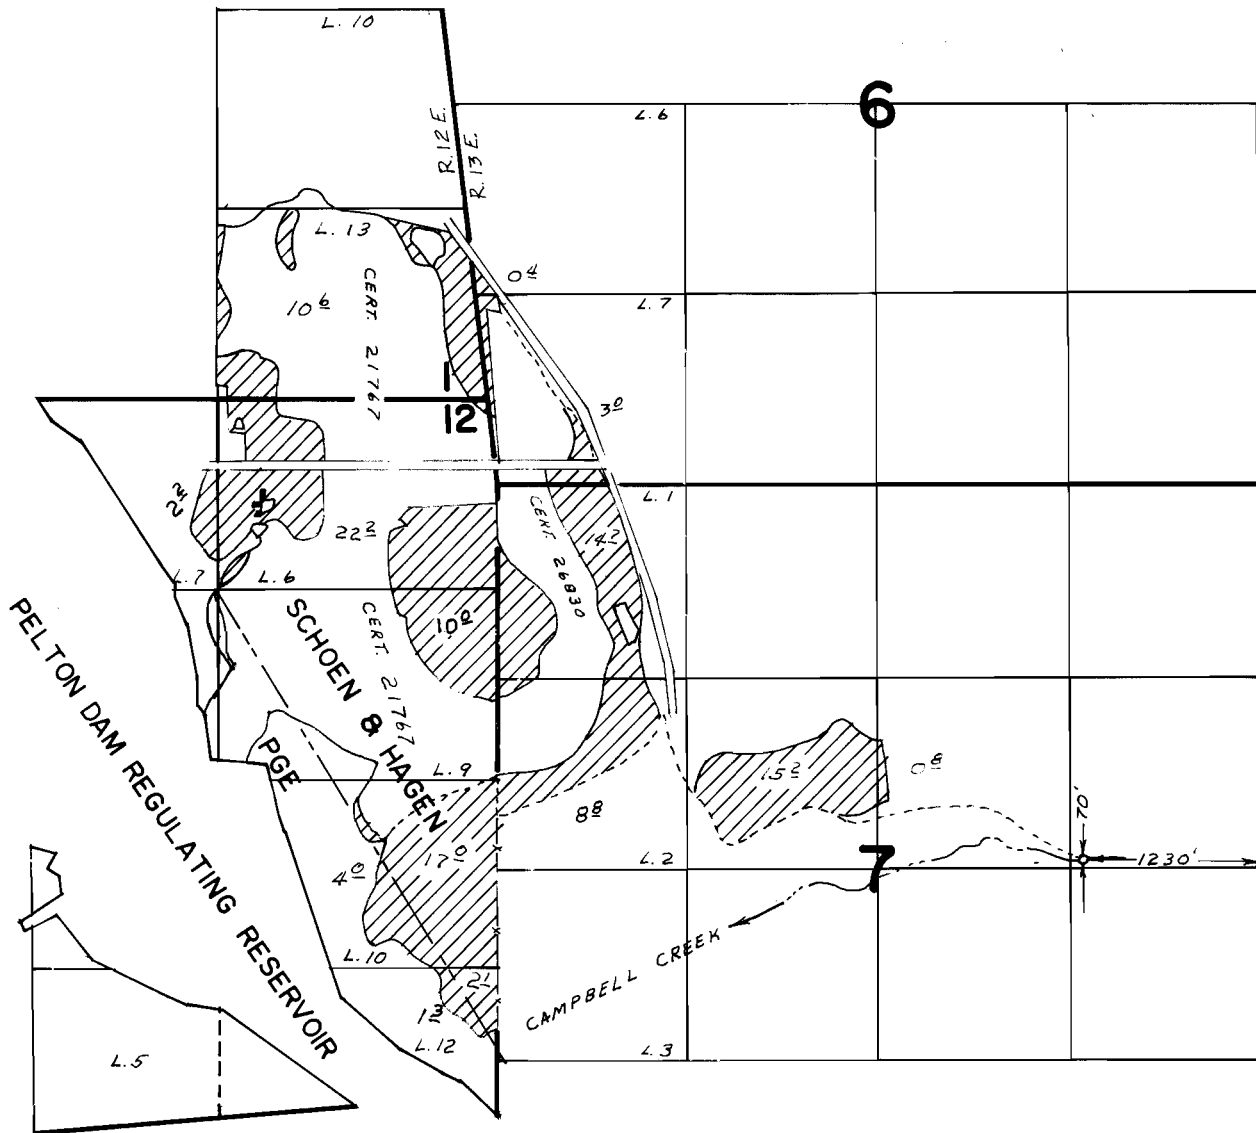

## FINAL PROOF SURVEY UNDER

Application No. 55021... Permit No. 41276.....  
IN NAME OF

...**PAUL SCHOEN & ED HAGEN**...

Surveyed MAY 1..... 1980., by L.H. NUNN.....