


T. 37 S., R. 9 W., W.M.

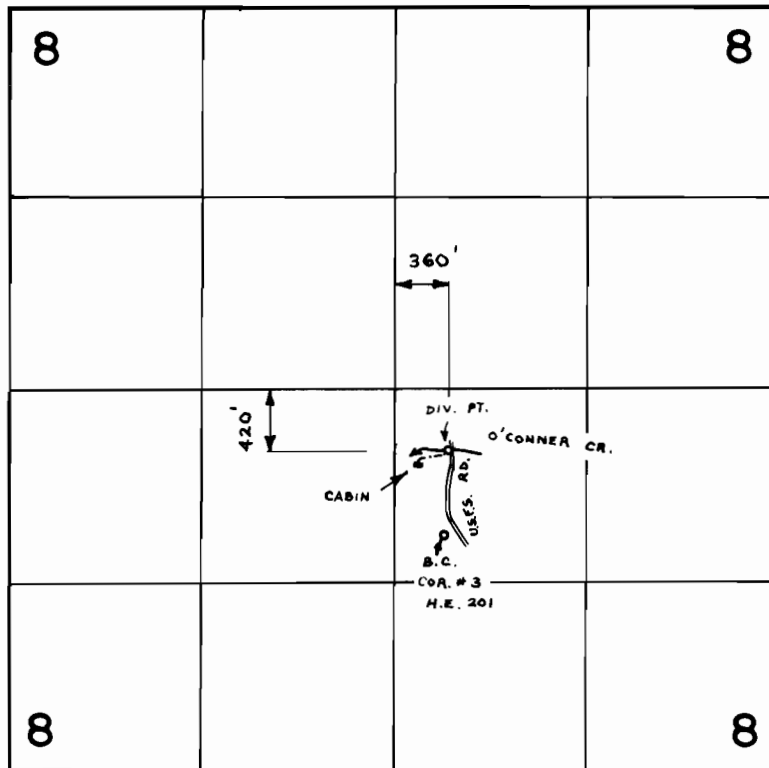

FINAL PROOF SURVEY UNDER

Application No. 49645 Permit No. 36786
IN NAME OF

J. ROBERT EGAN

Surveyed AUG. 23 1978, by B. SUND