


# T. 36 S., R. 7 W., W.M.

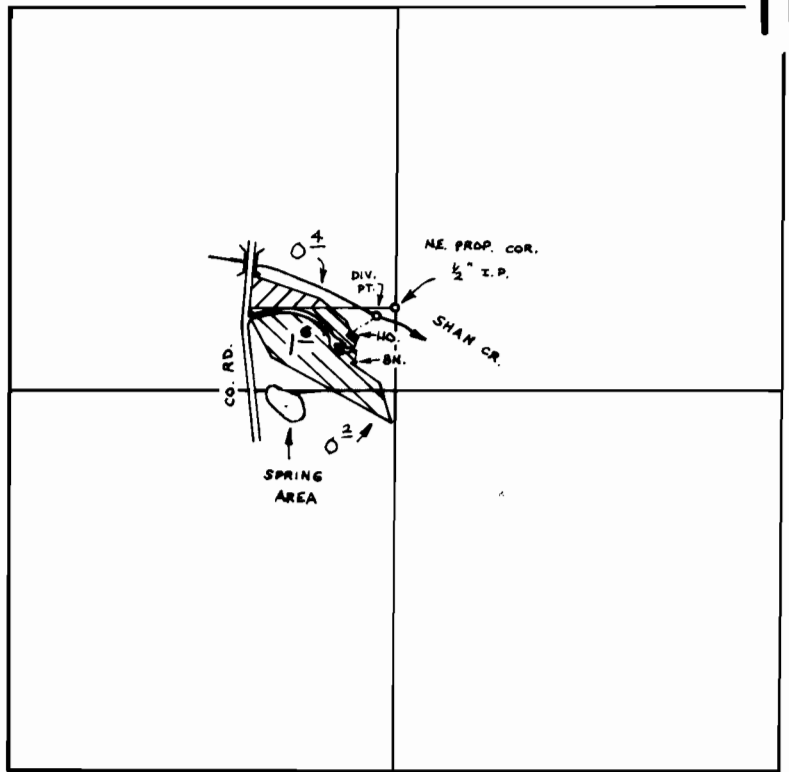

DIV. PT. LOC.: 1060'S. & 1250'E., SPRING LOC. - 1350'S. & 950'E.,  
 BOTH FROM W. 1/4 COR., SEC. 11.

SCALE: 1" = 660 FT.

## FINAL PROOF SURVEY UNDER

51002	38496	
50119	37661	

Application No. 50704 Permit No. 38297  
 IN NAME OF

DANIEL LARRY JACKSON

Surveyed NOV. 14 1977, by B. SUND