


T. 36 S., R. 7 W., W.M.

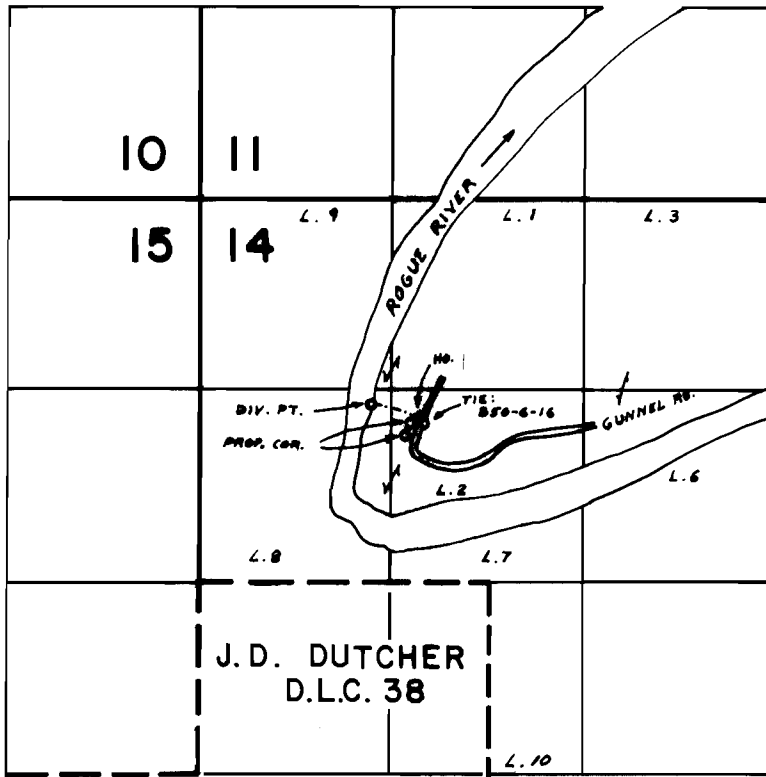

DIV. PT. LOC. : 90' S. & 130' W. FROM NW 1/4 COR. SEC. 14

FINAL PROOF SURVEY
UNDER

Application No. 55927 Permit No. 42147
IN NAME OF

CHARLES A. SMITH

Surveyed OCT. 23 1978, by B. SUND

B50-6-16 &

P.T.S. - 1978 - 14 - D