


T.39 S., R.7 W., W.M.

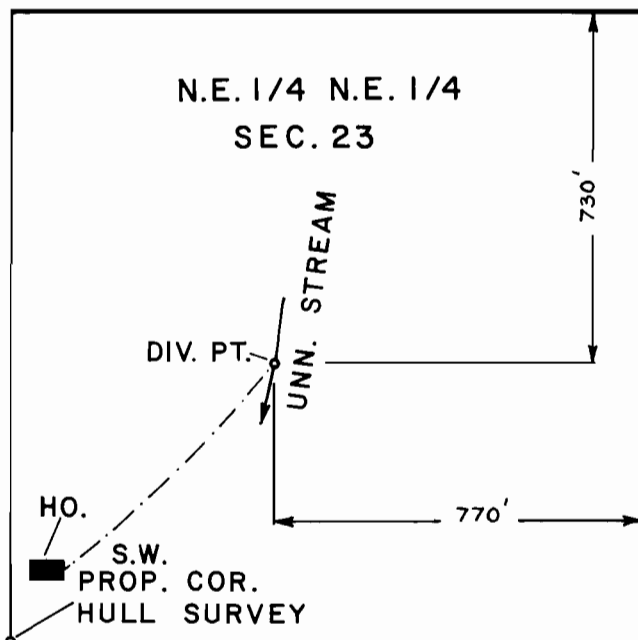

SCALE : 1" = 400 FT.

FINAL PROOF SURVEY
UNDER

Application No. 57810 Permit No. 43590
IN NAME OF
CHARLES W. D'ARPINO

Surveyed JUN. 11 1979, by B. SUND

D.H.M.
P.T.S. - 1979-14-B