


T.17S. R.3W., W.M.

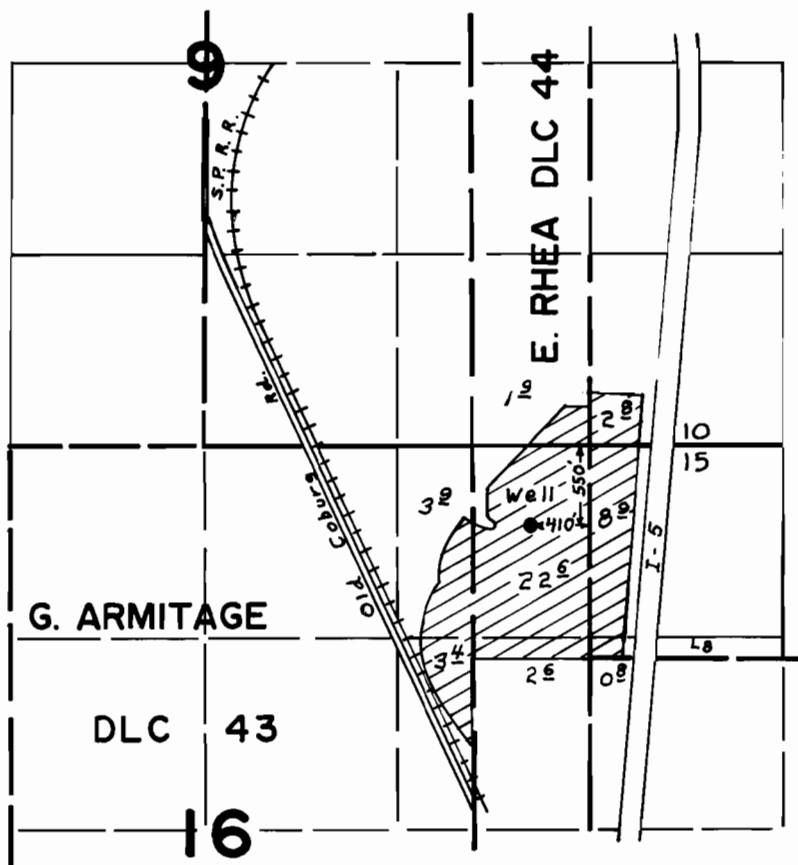

FINAL PROOF SURVEY UNDER

Application No. G-7994. Permit No. G-7416.
IN NAME OF

RAYMOND W. HOILAND

Surveyed MAY 15, 1978, by J. S. DONALDSON