


T.18S. R.3W., W.M.

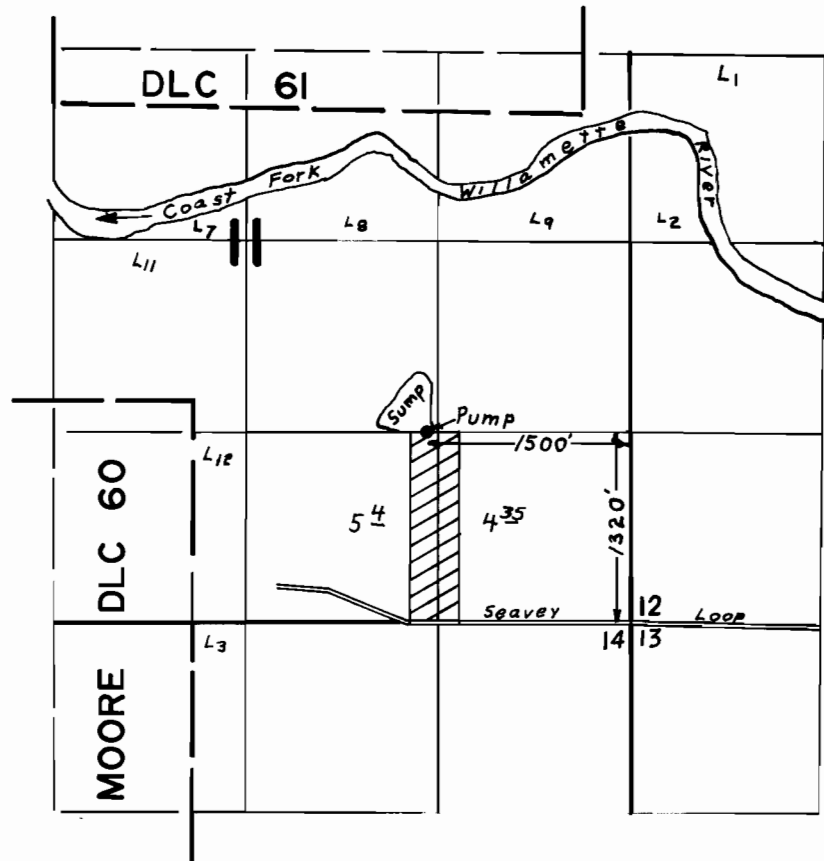

FINAL PROOF SURVEY UNDER

Application No. G-8760. Permit No. G-8127....
IN NAME OF

.....FRANK C. STEC.....

Surveyed SEP. 12. 1978., by J.S. DONALDSON